



GEORGE ENGLAND

APRIL 1953

FRED L. DOW

SCALE 1" = 100'

CIVIL ENGINEER

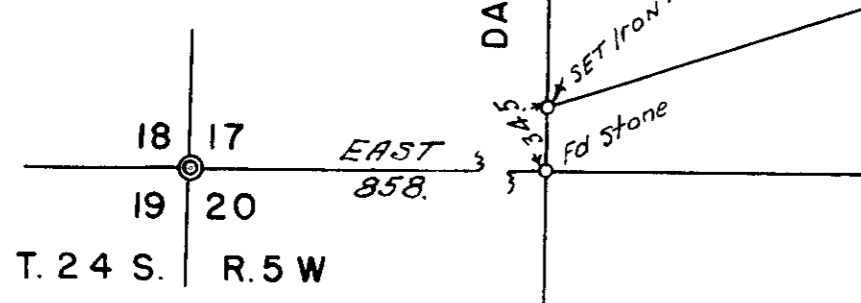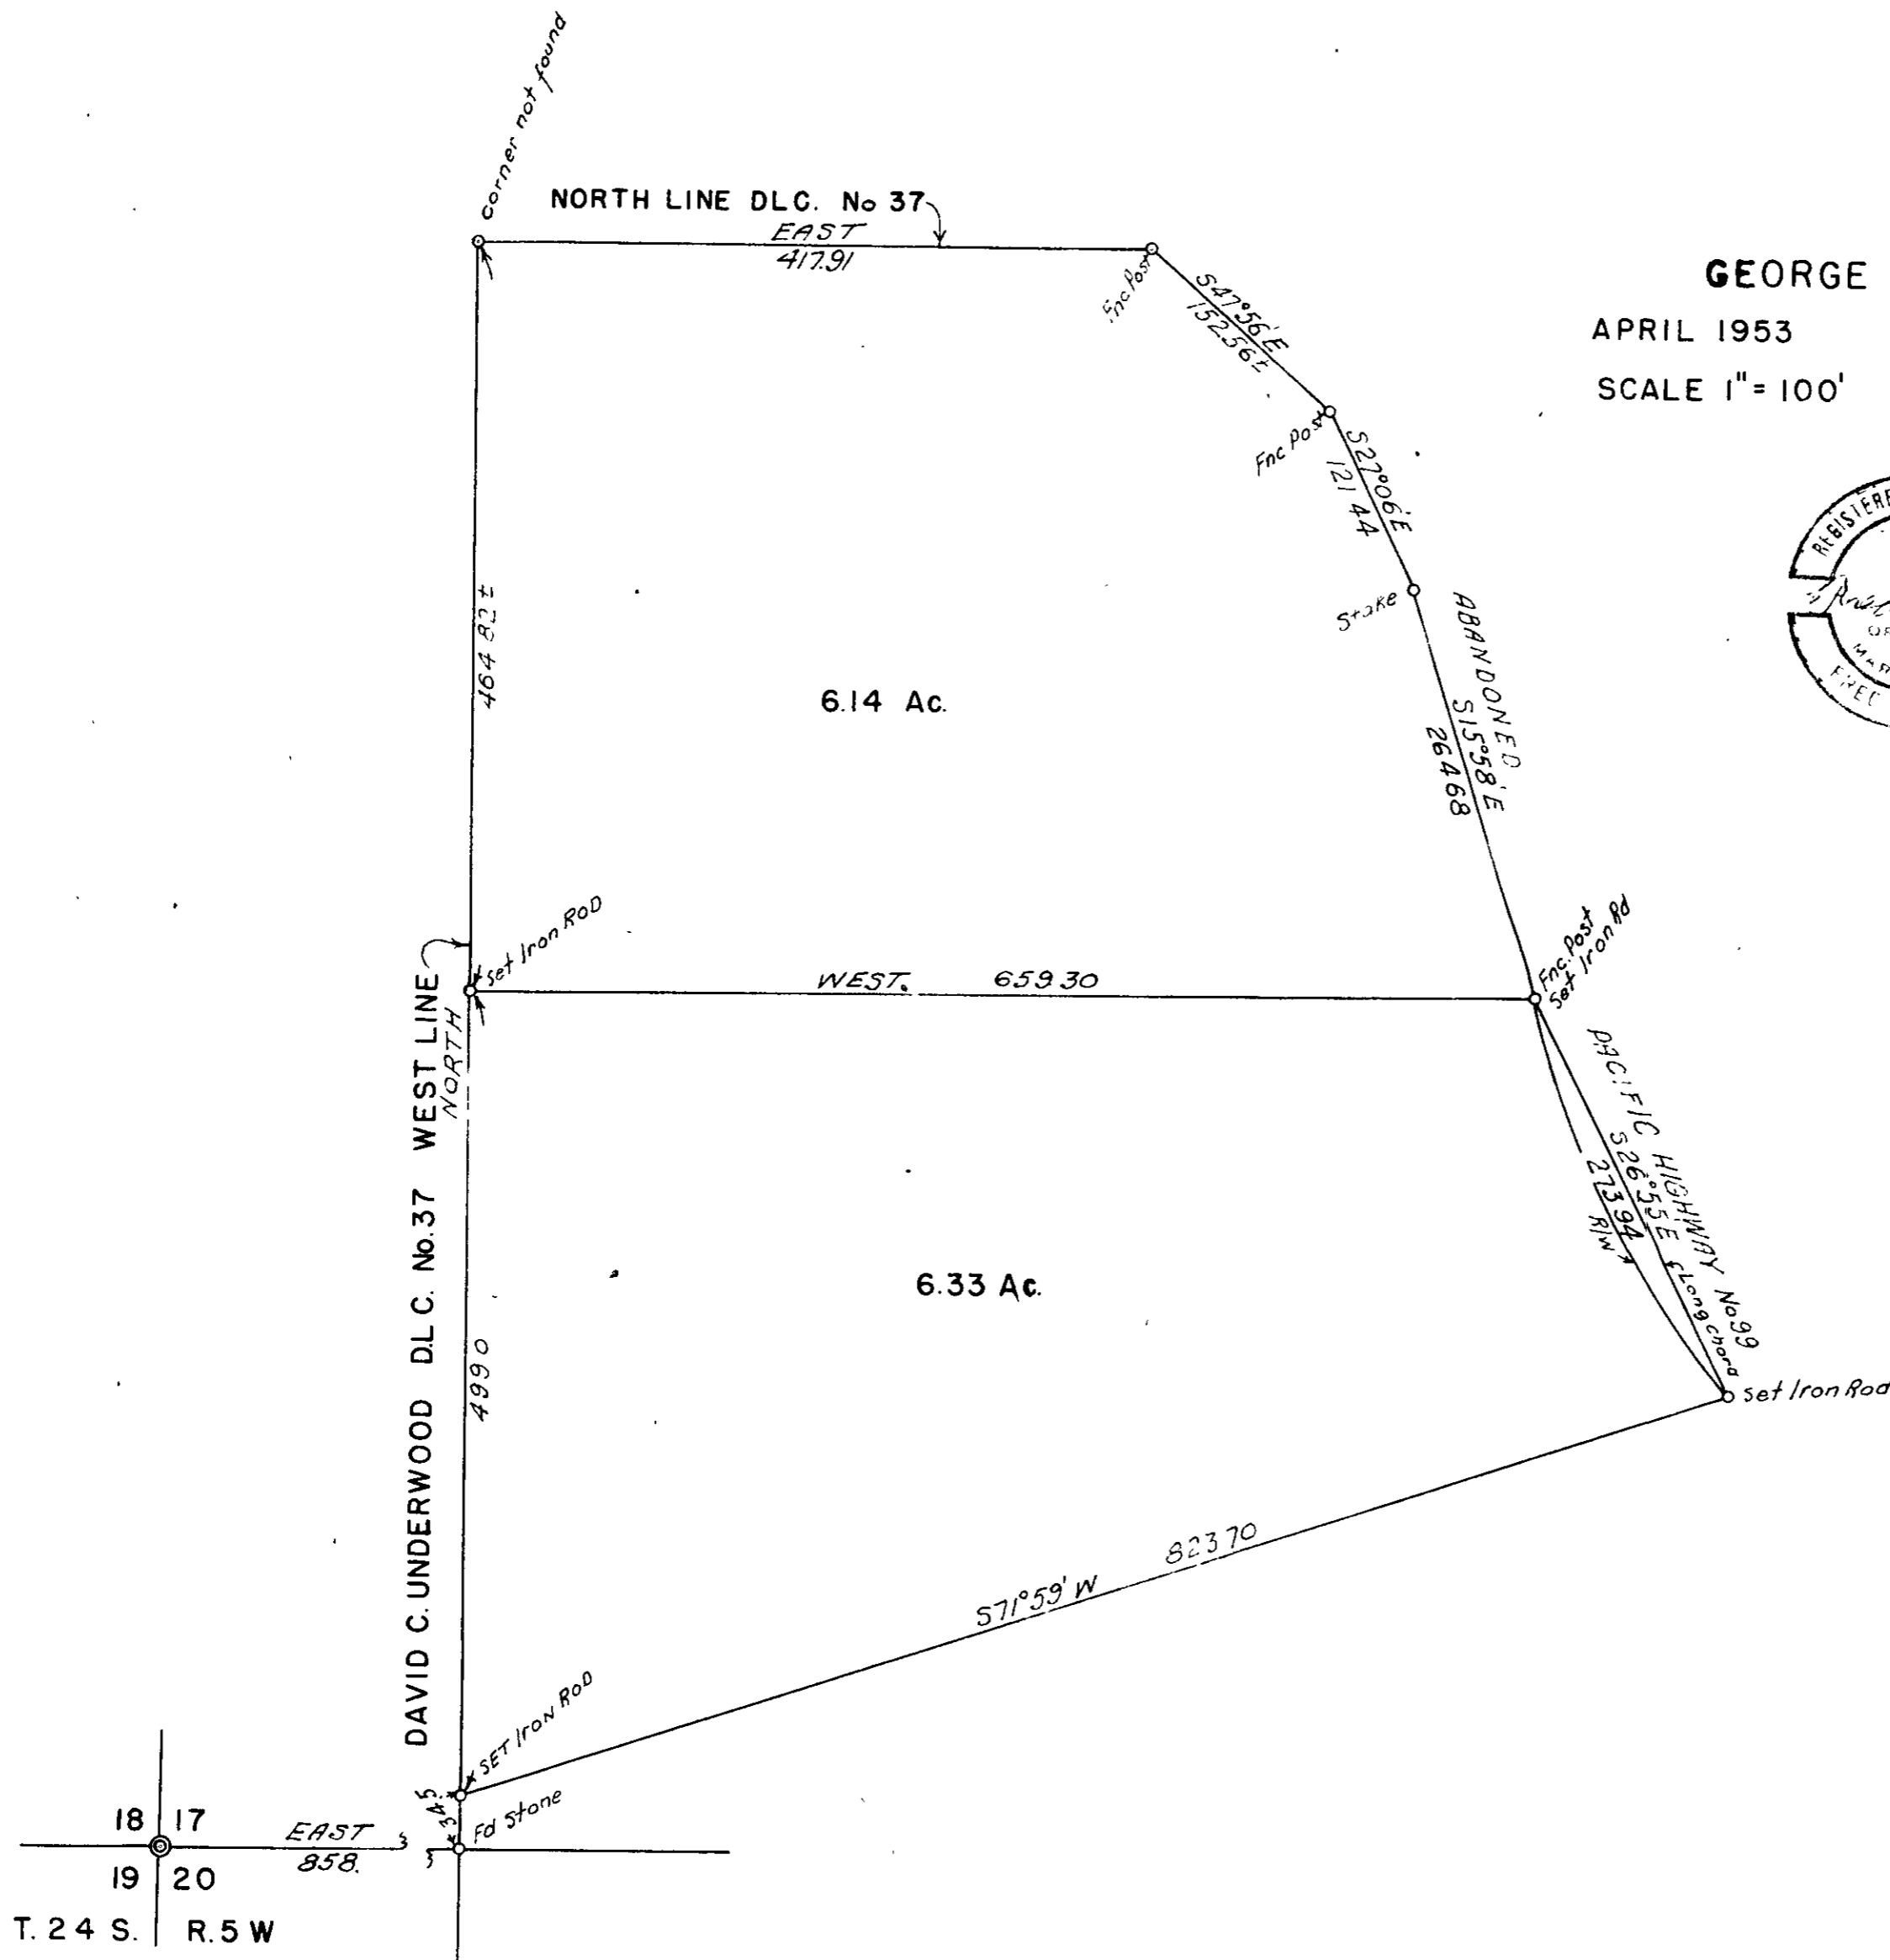

FOR LOCAL TRACING
SEE 119-60