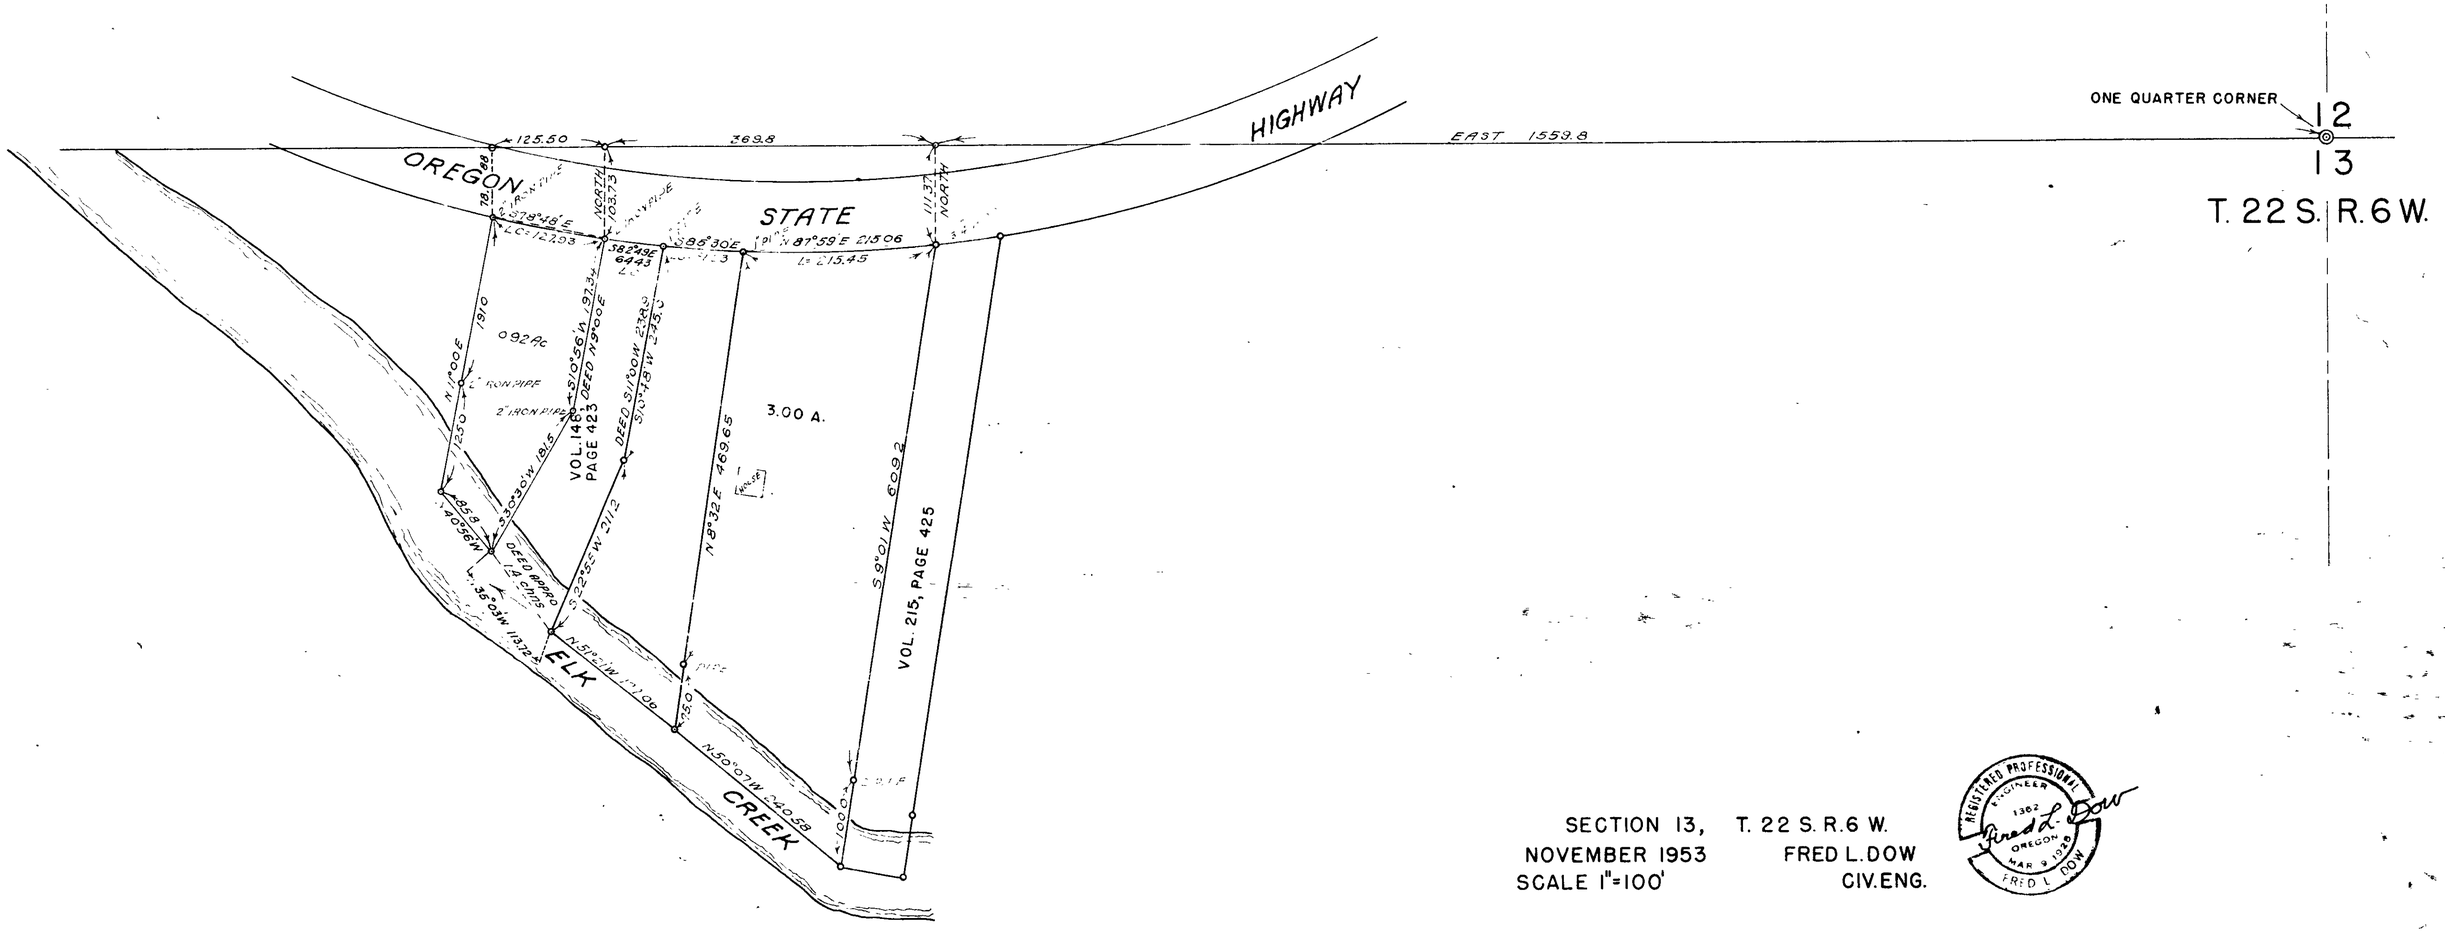

SECTION 13, T. 22 S. R. 6 W.
NOVEMBER 1953 FRED L. DOW
SCALE 1"=100' CIV. ENG.

REGISTERED PROFESSIONAL ENGINEER 1362 OREGON MAR 9 1928 FRED L. DOW

G.S. File No. 50/38