I, FRED L. DOW OF SUTHERLIN, OREGON DO HEREBY CERTIFY THAT THIS MAP WAS MADE FROM NOTES TAKEN DURING AN ACTUAL SURVEY MADE BY ME ON JULY 28, 1951; THAT THE MONUMENT SHOWN ON THIS MAP CONSISTING OF A 1"X 36" IRON PIPE IS S 87°12'W 2068 FEET FROM THE S.W. CORNER OF THE EAST EXTENSION OF THE SHADROCK HUDSON D.L.C. IN SECTIONS 27 & 28, T. 23 S. R. 7 W.

Fred L. Dow

CIVIL ENGINEER

EUGENE H. FISHER
OAKLAND — OREGON

SCALE 1" = 300'

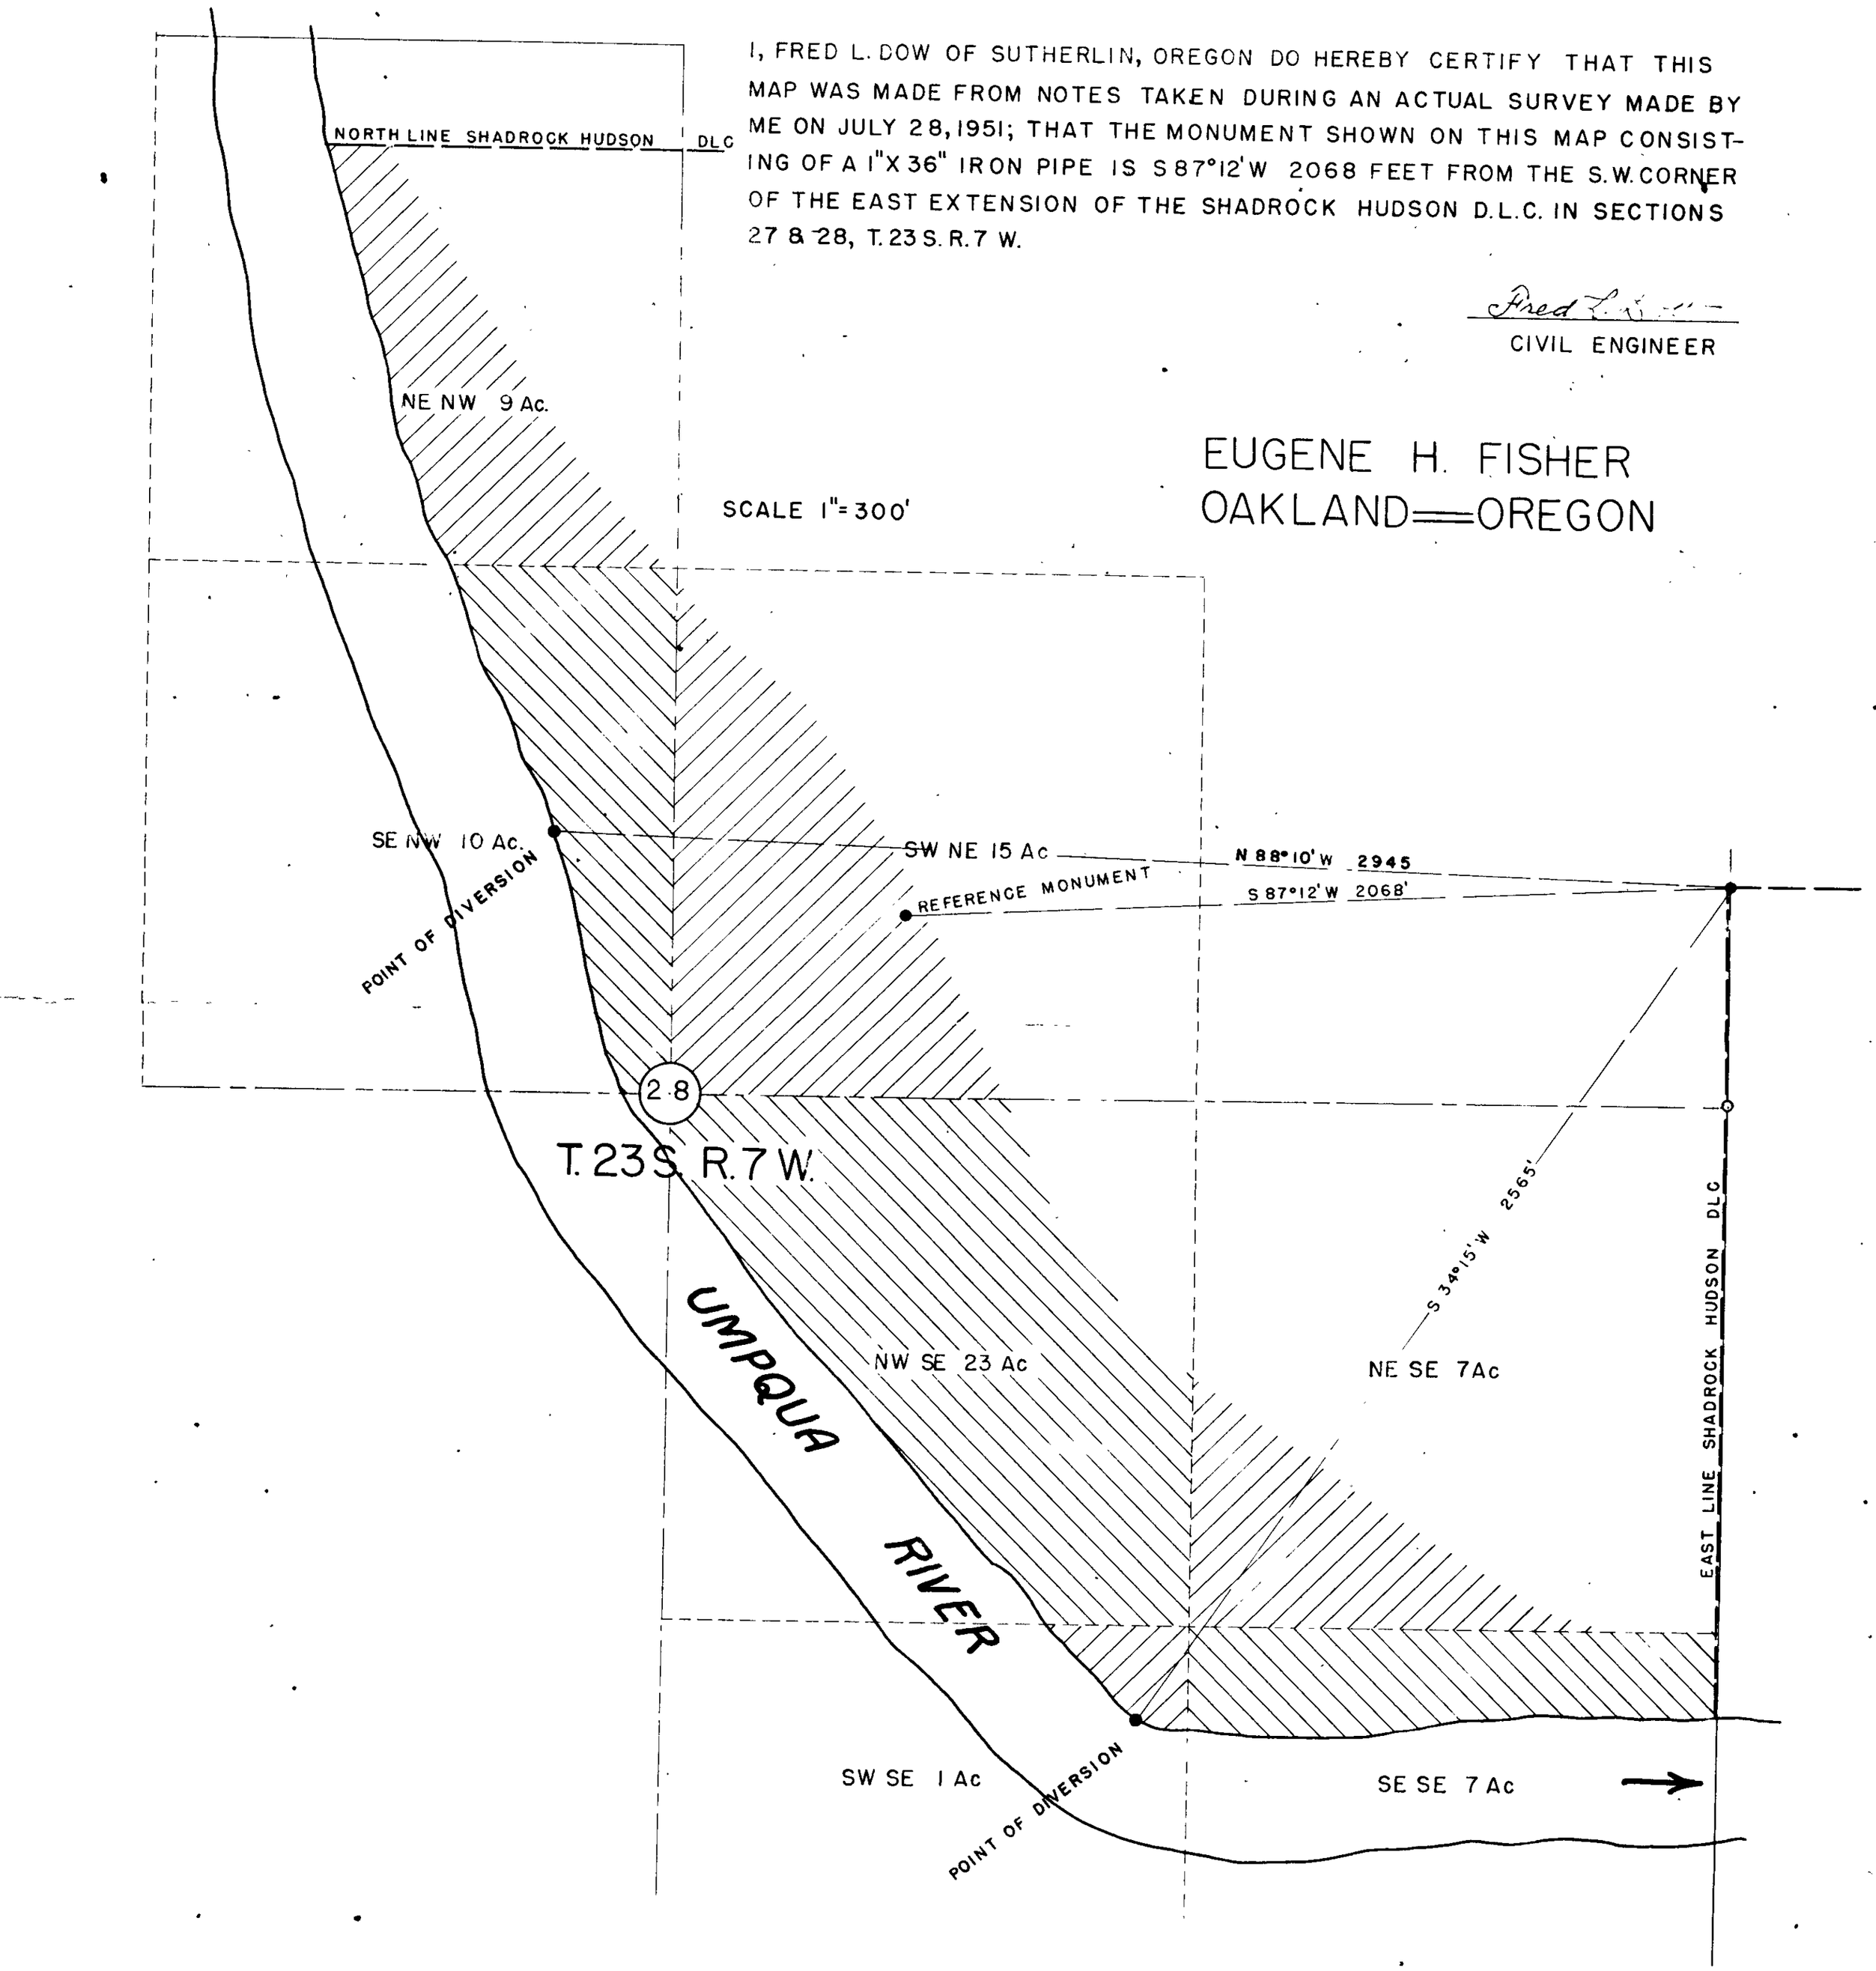

C. S. File No. 30/90