PART OF LOT 8, BLOCK 1 & LOT 6, BLOCK 2
PLAT E S.L. & W. Co.
1 MARCH 1956 SCALE 1"=100'

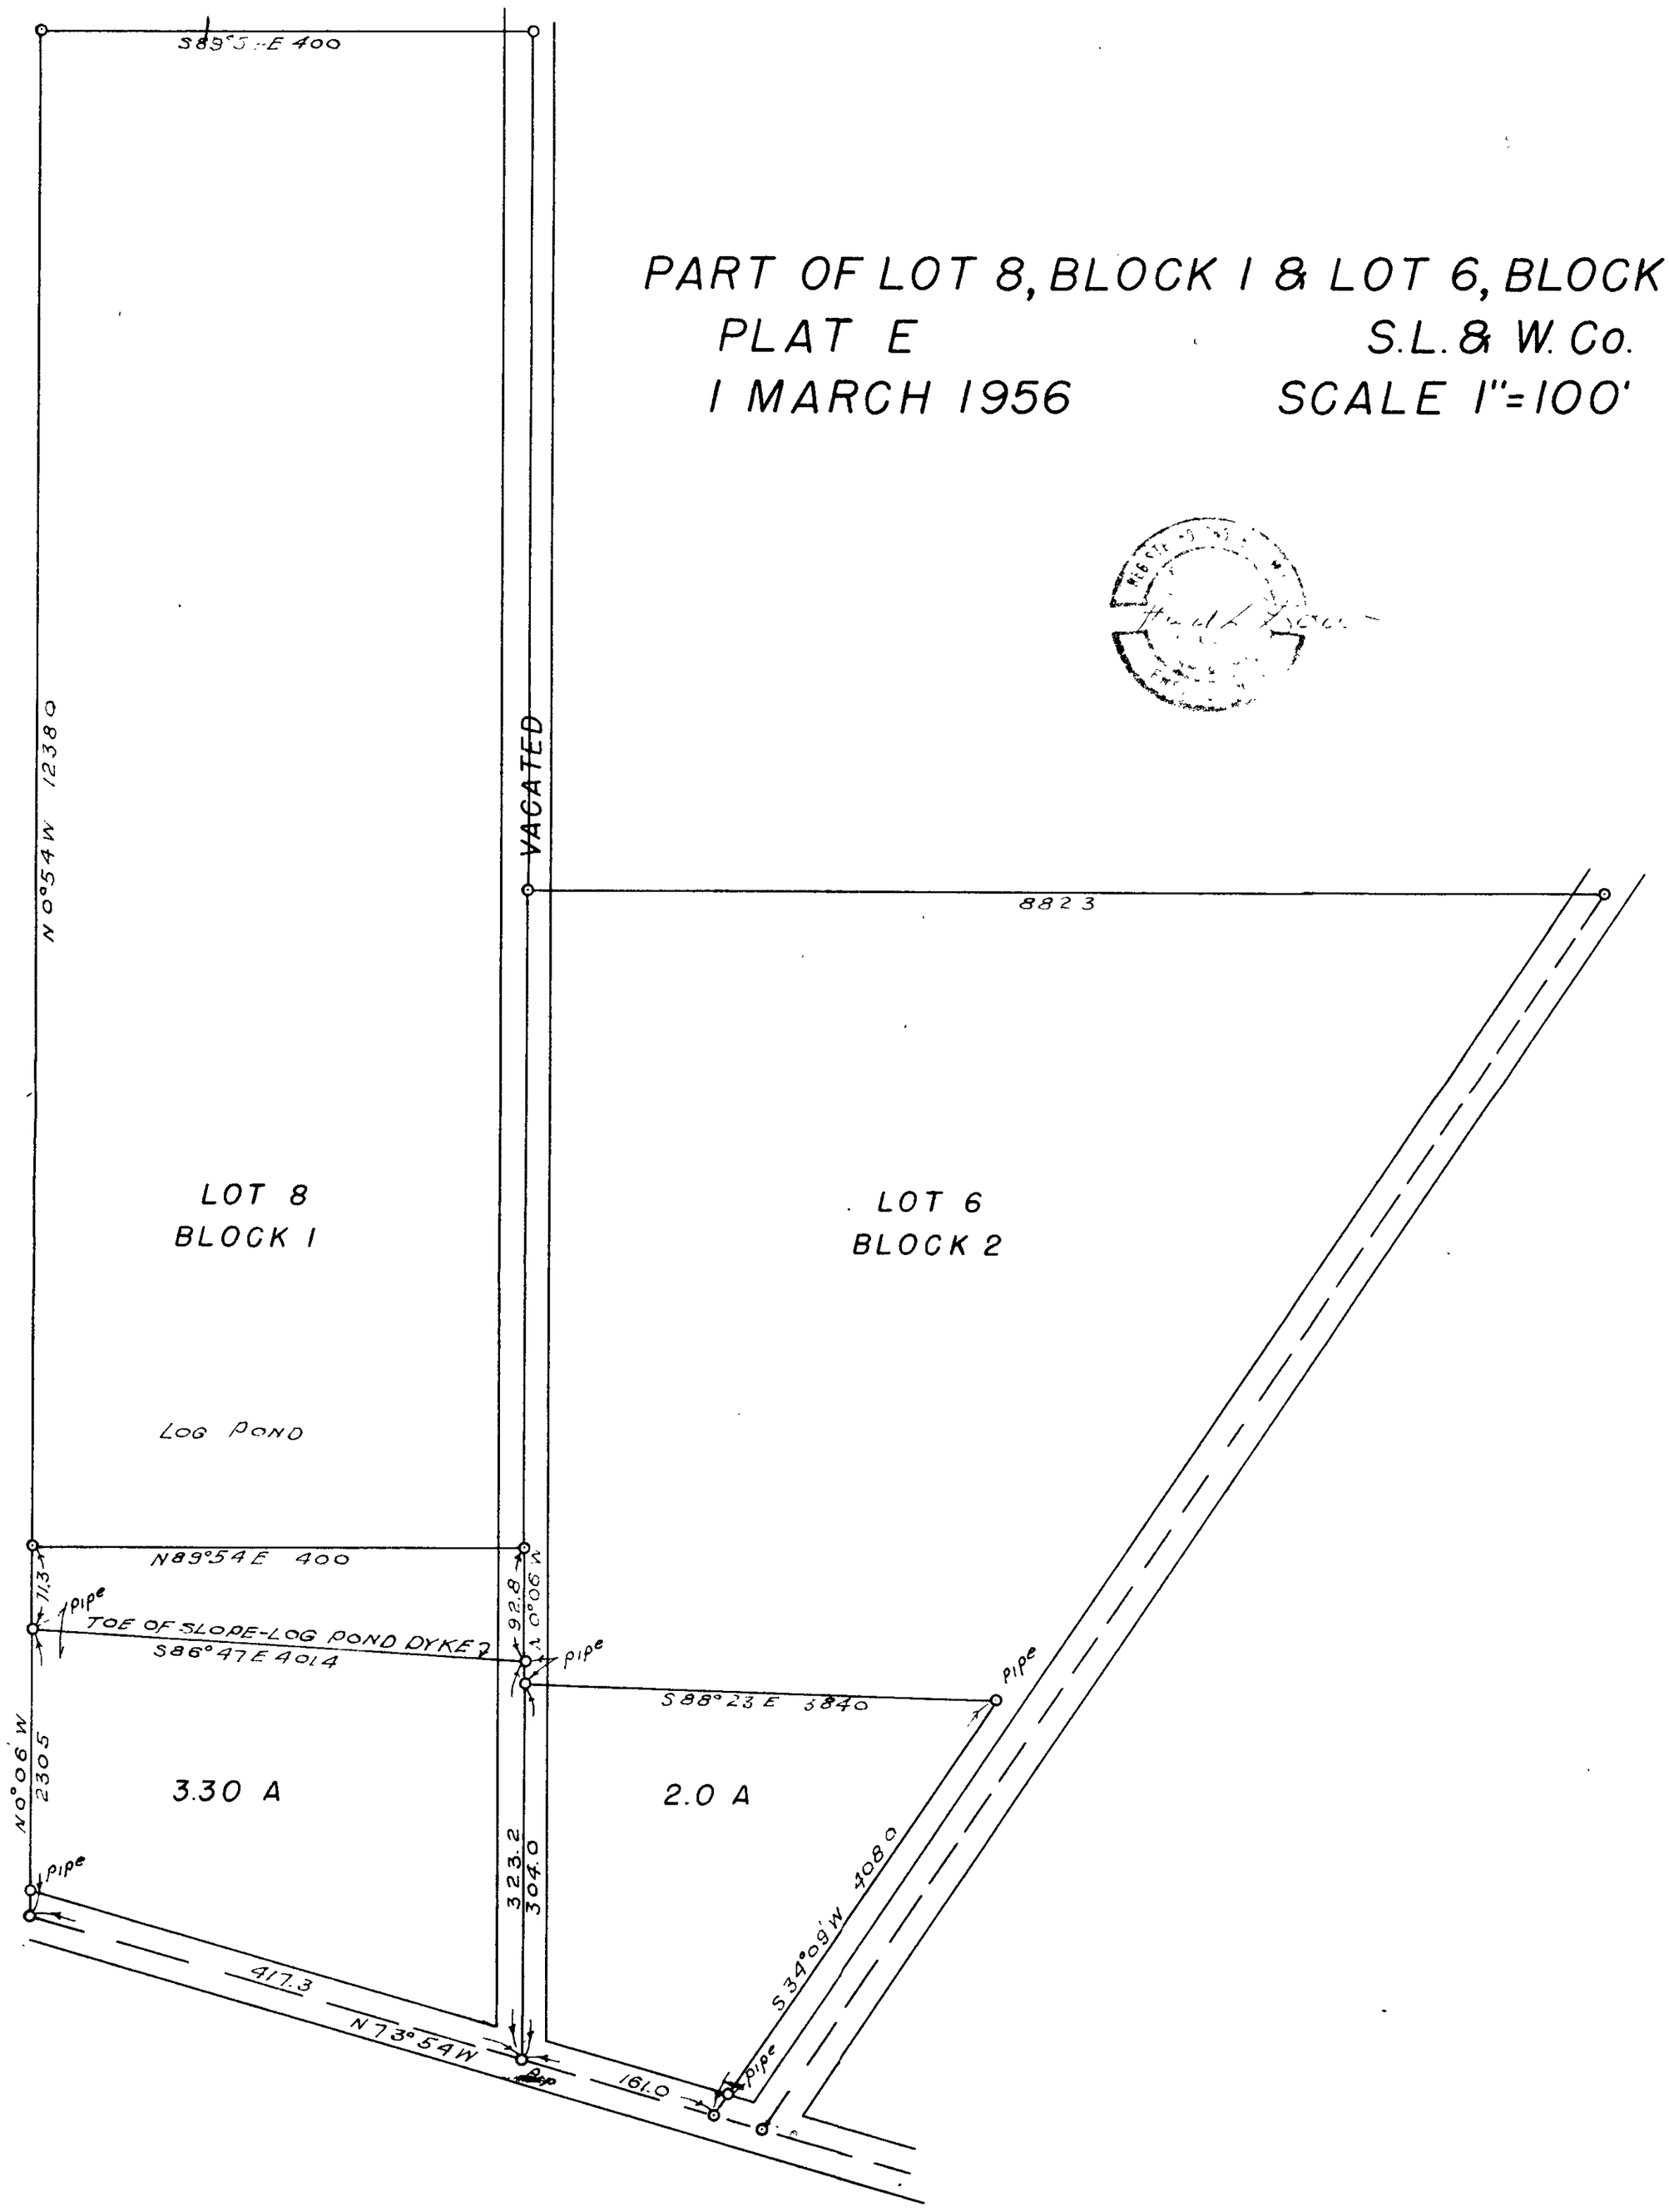

C.S. File No. 50/48