BUD HOLM

SUTHERLIN OREGON

SECTION 20, T. 25 S.R. 5 W.
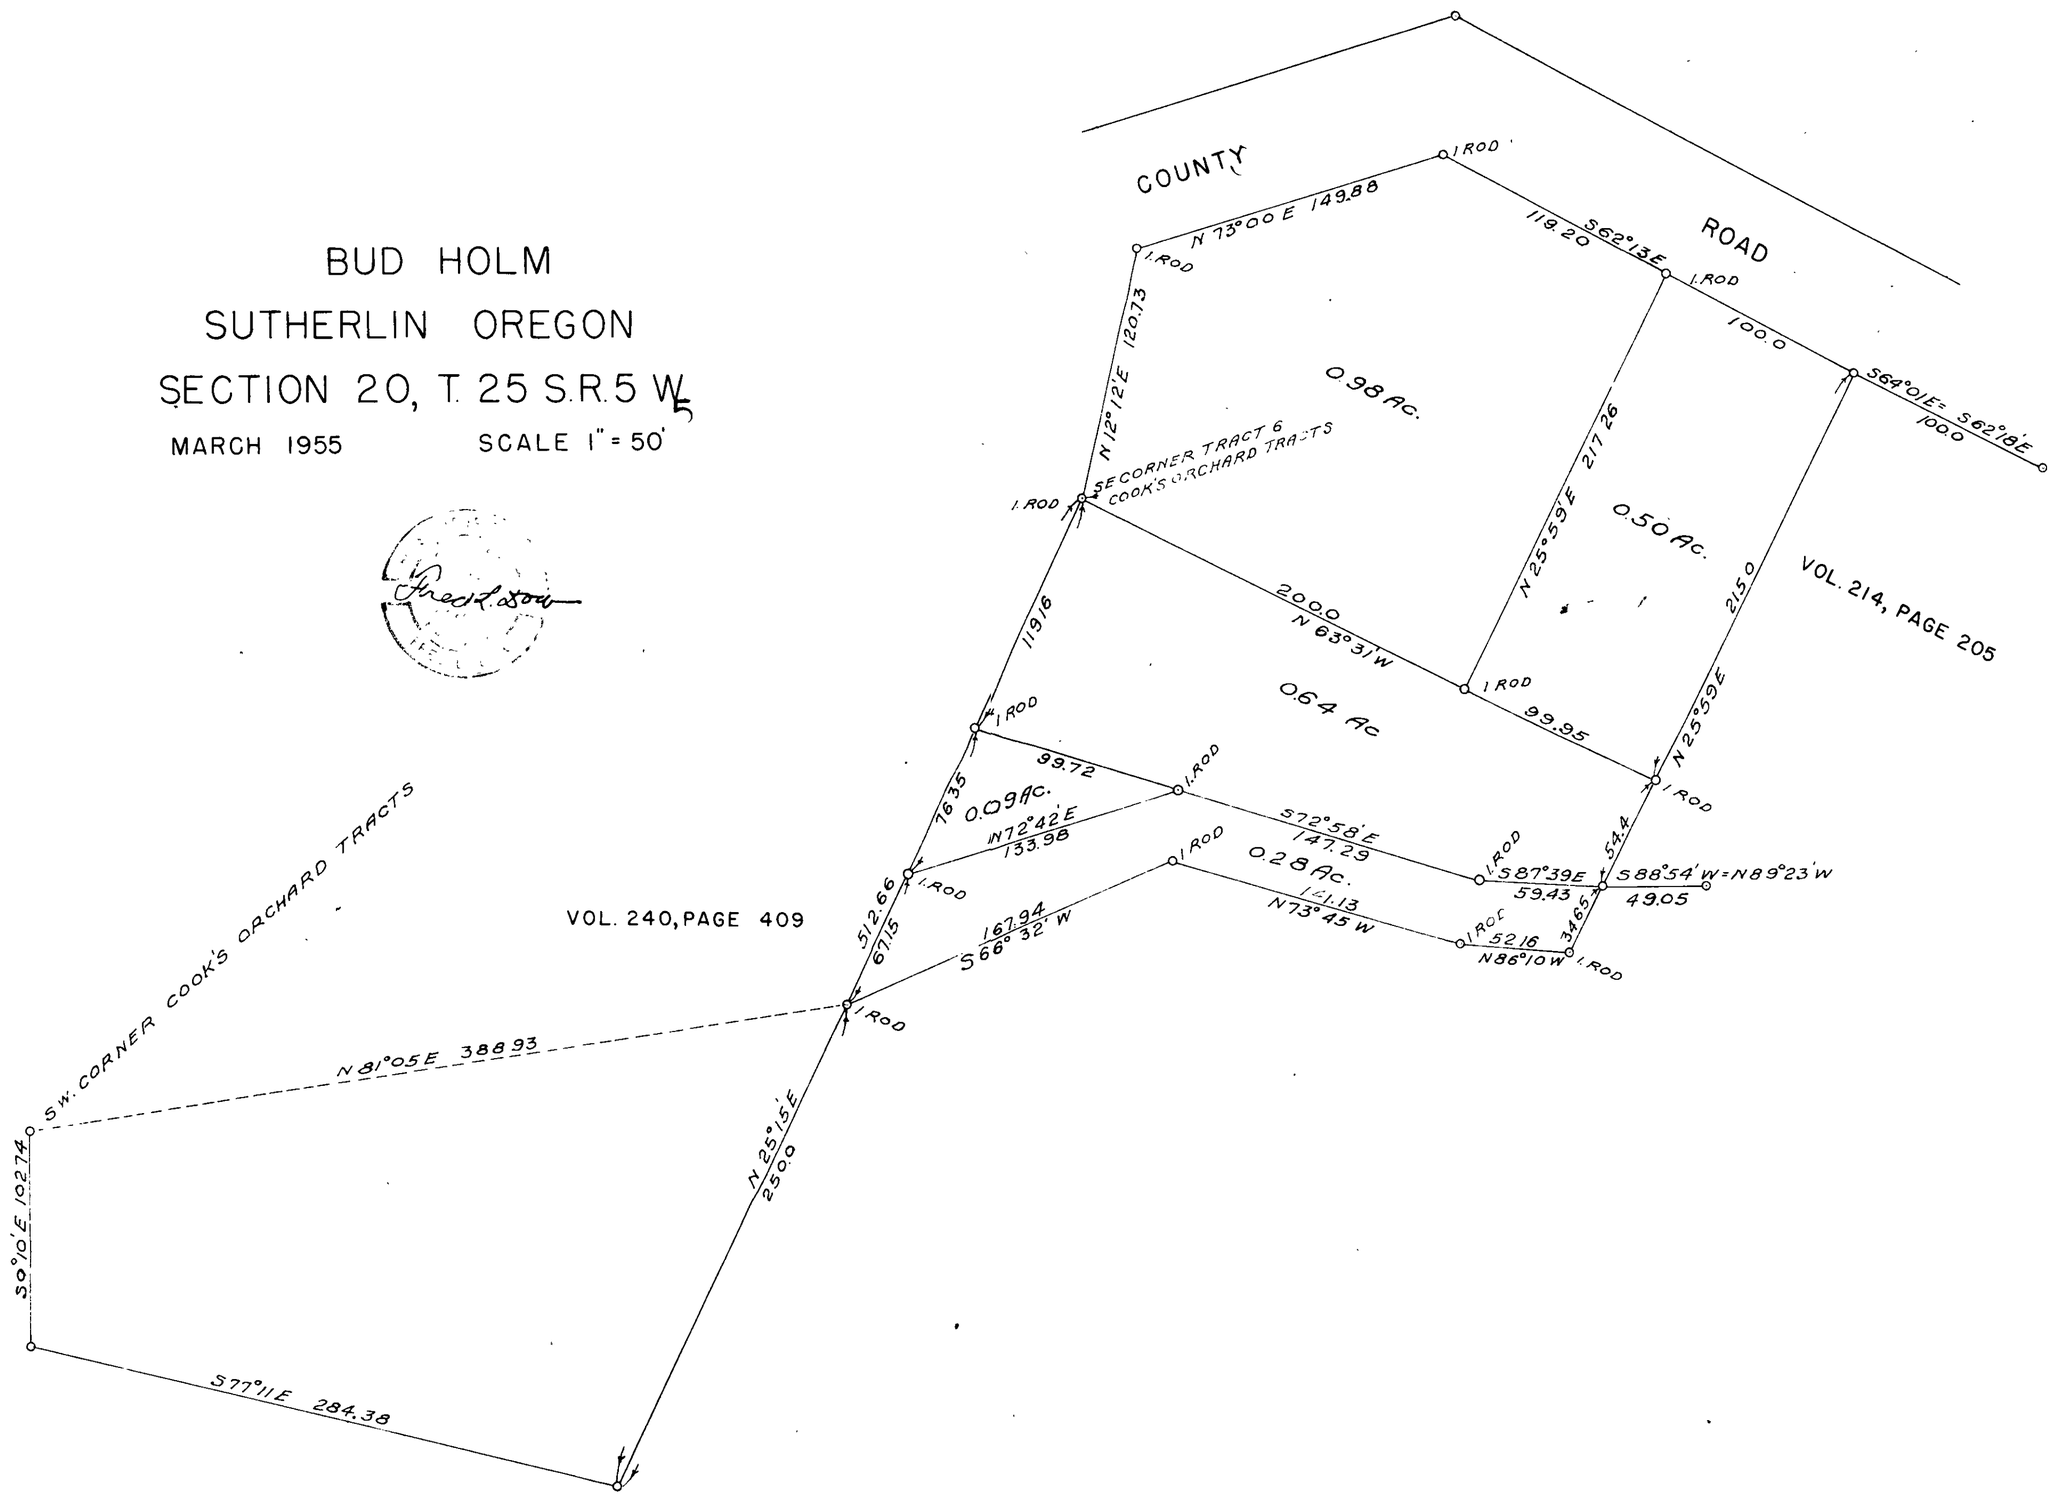
MARCH 1955 SCALE 1" = 50'