G 4781
(1 chain strip ?)
Corner of 120x240 ?
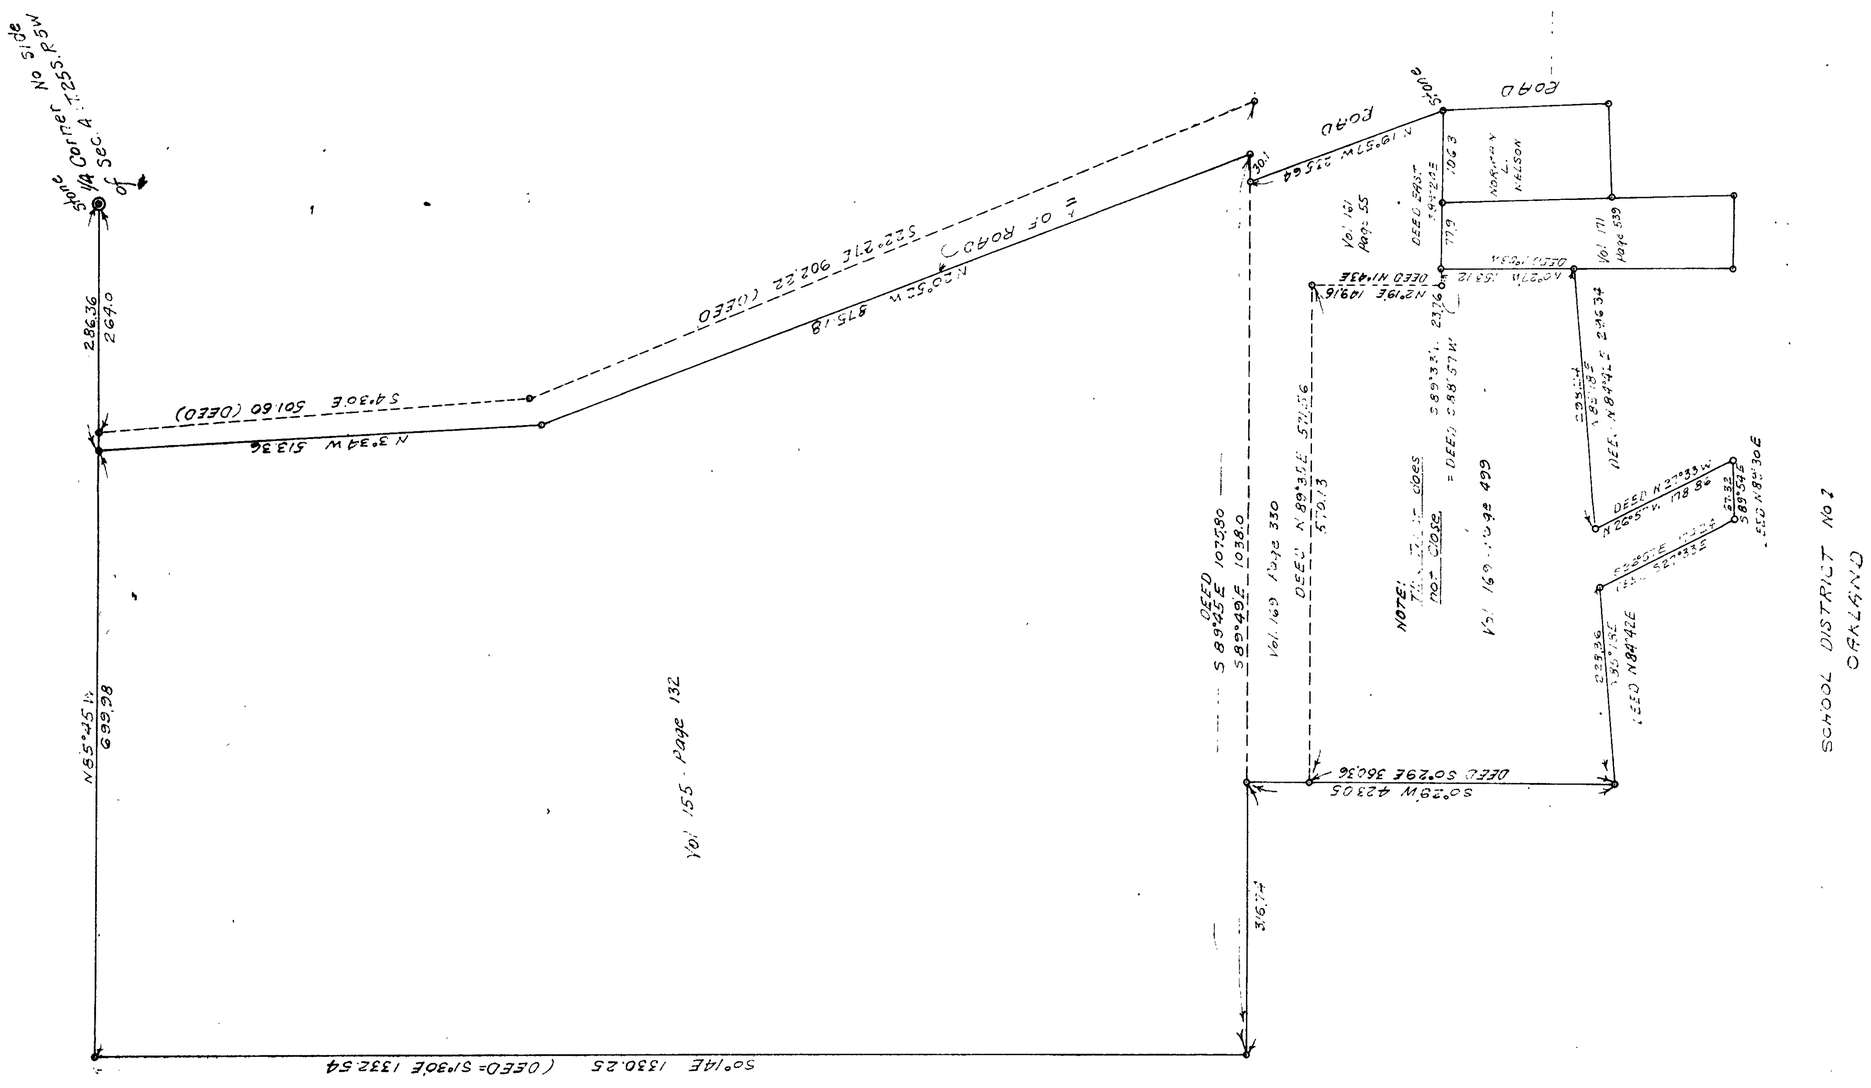
50/102