C.S. File No. 50/118

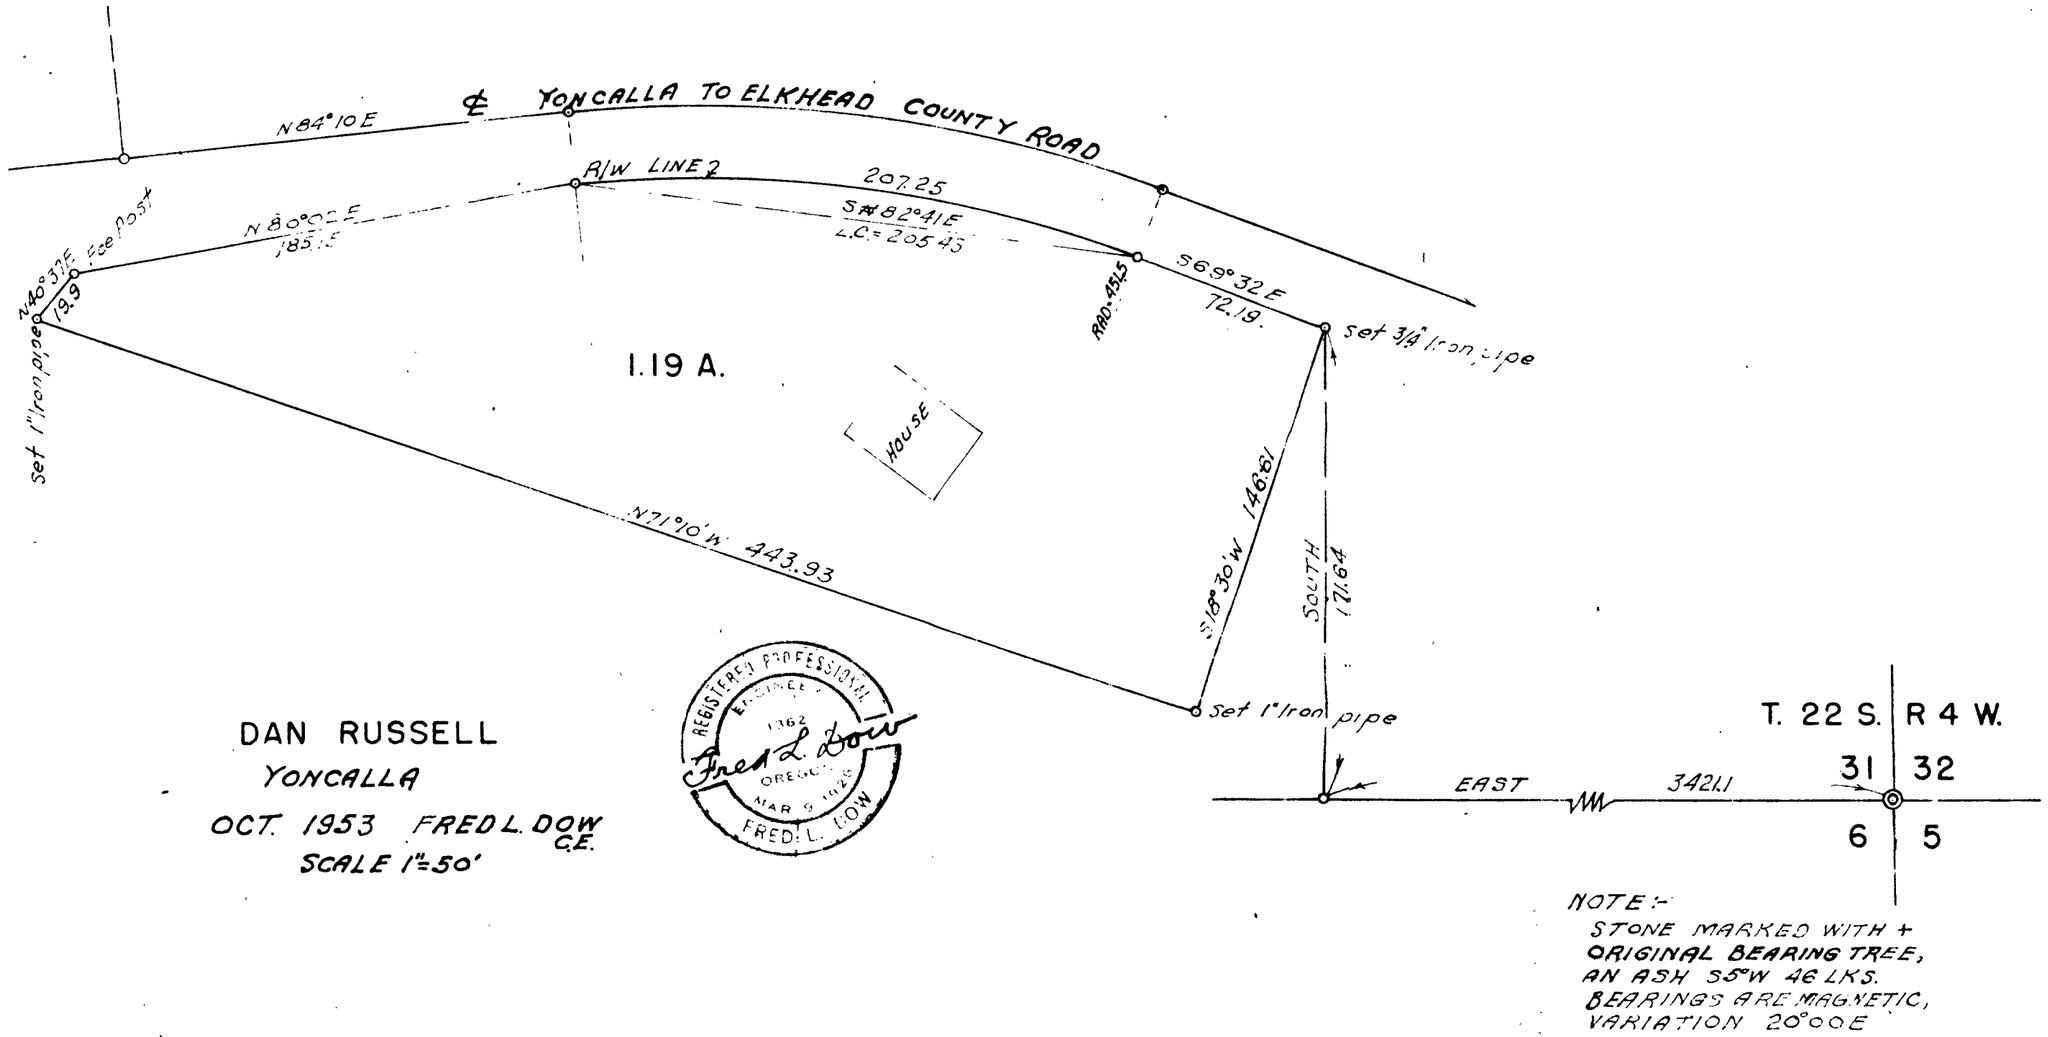

DAN RUSSELL
YONCALLA
OCT. 1953 FRED L. DOW C.E.
SCALE 1"=50'

REGISTERED PROFESSIONAL ENGINEER 1362 OREGON MAR 9 1926 FRED L. DOW