
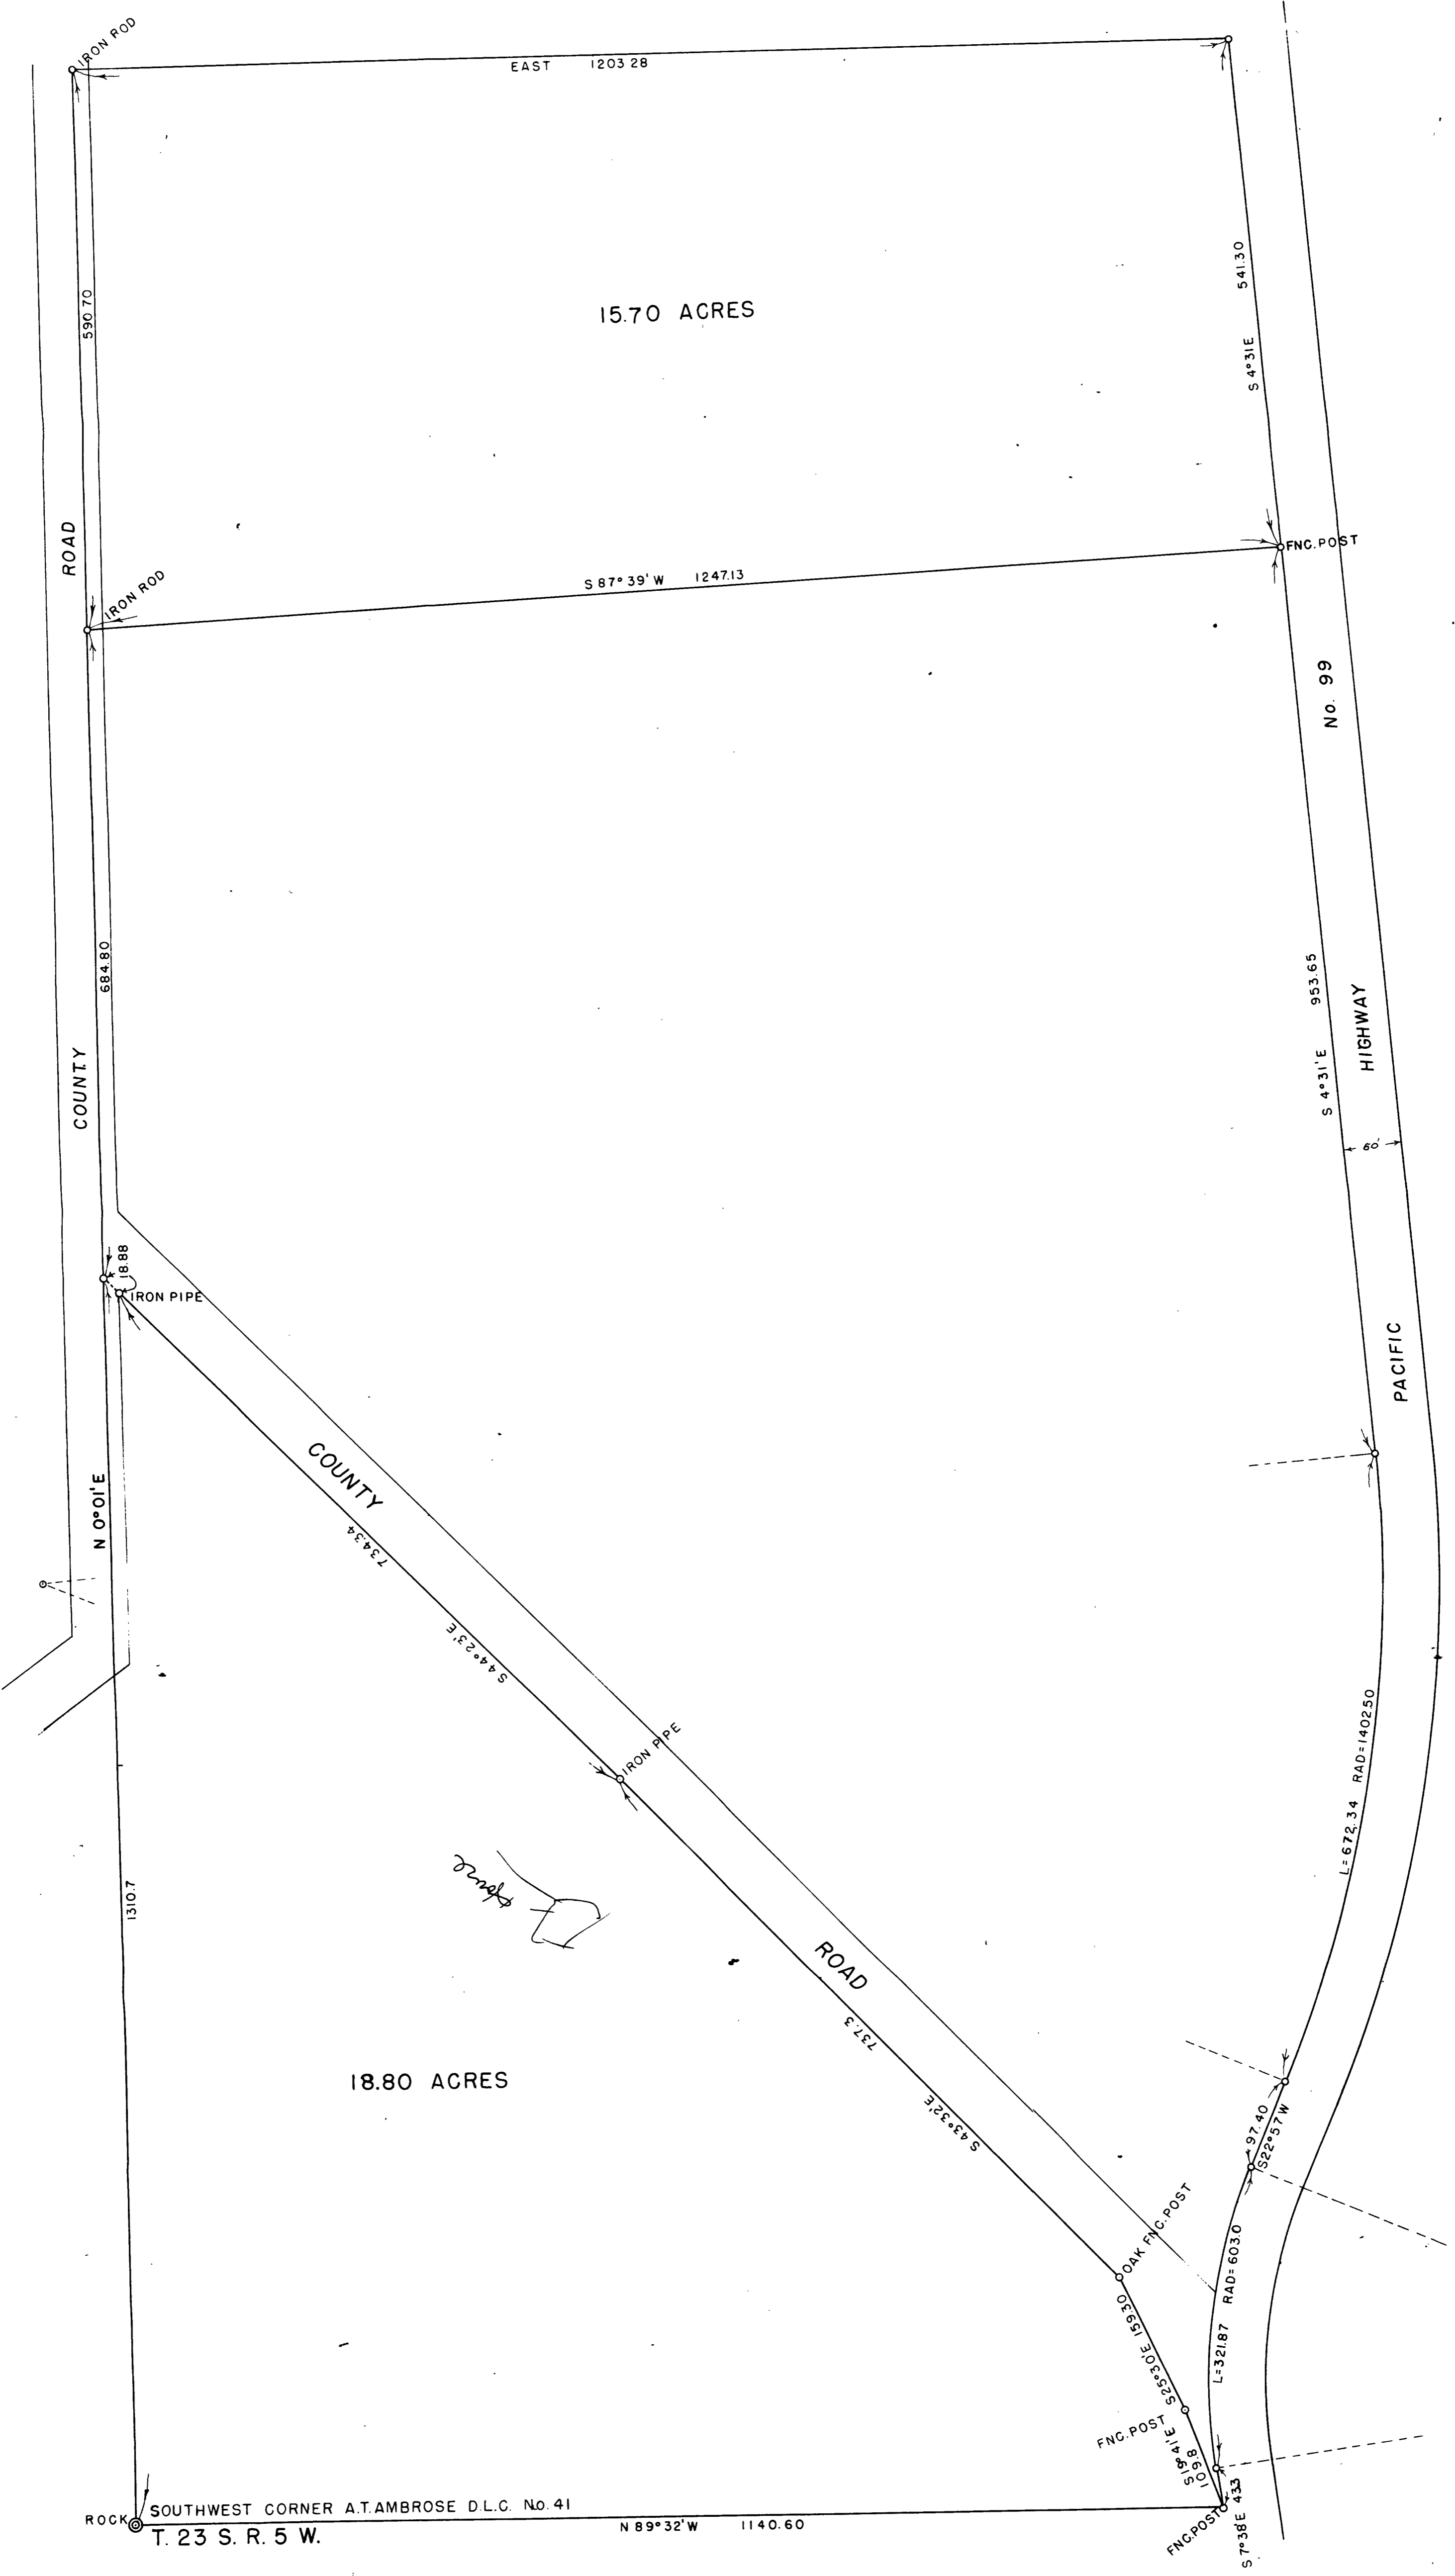


HERMAN SCHOSSO  
 PART OF SOUTH HALF OF D.L.C. No. 41  
 SECTION 10, T. 23 S. R. 5 W.  
 JUNE 1954 SCALE 1" = 100'

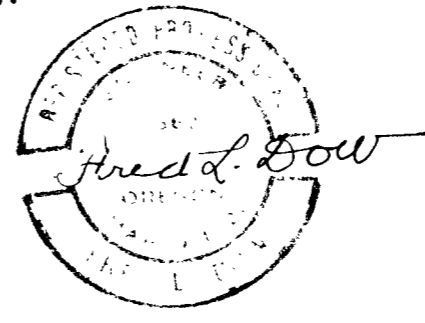

50/22