KENNITH P. SLAWSON

PART OF LOTS 2, 3, 14 AND 15

BLOCK 6 PLAT M

S.L. & W. Co

MARCH 1956 1" = 100'

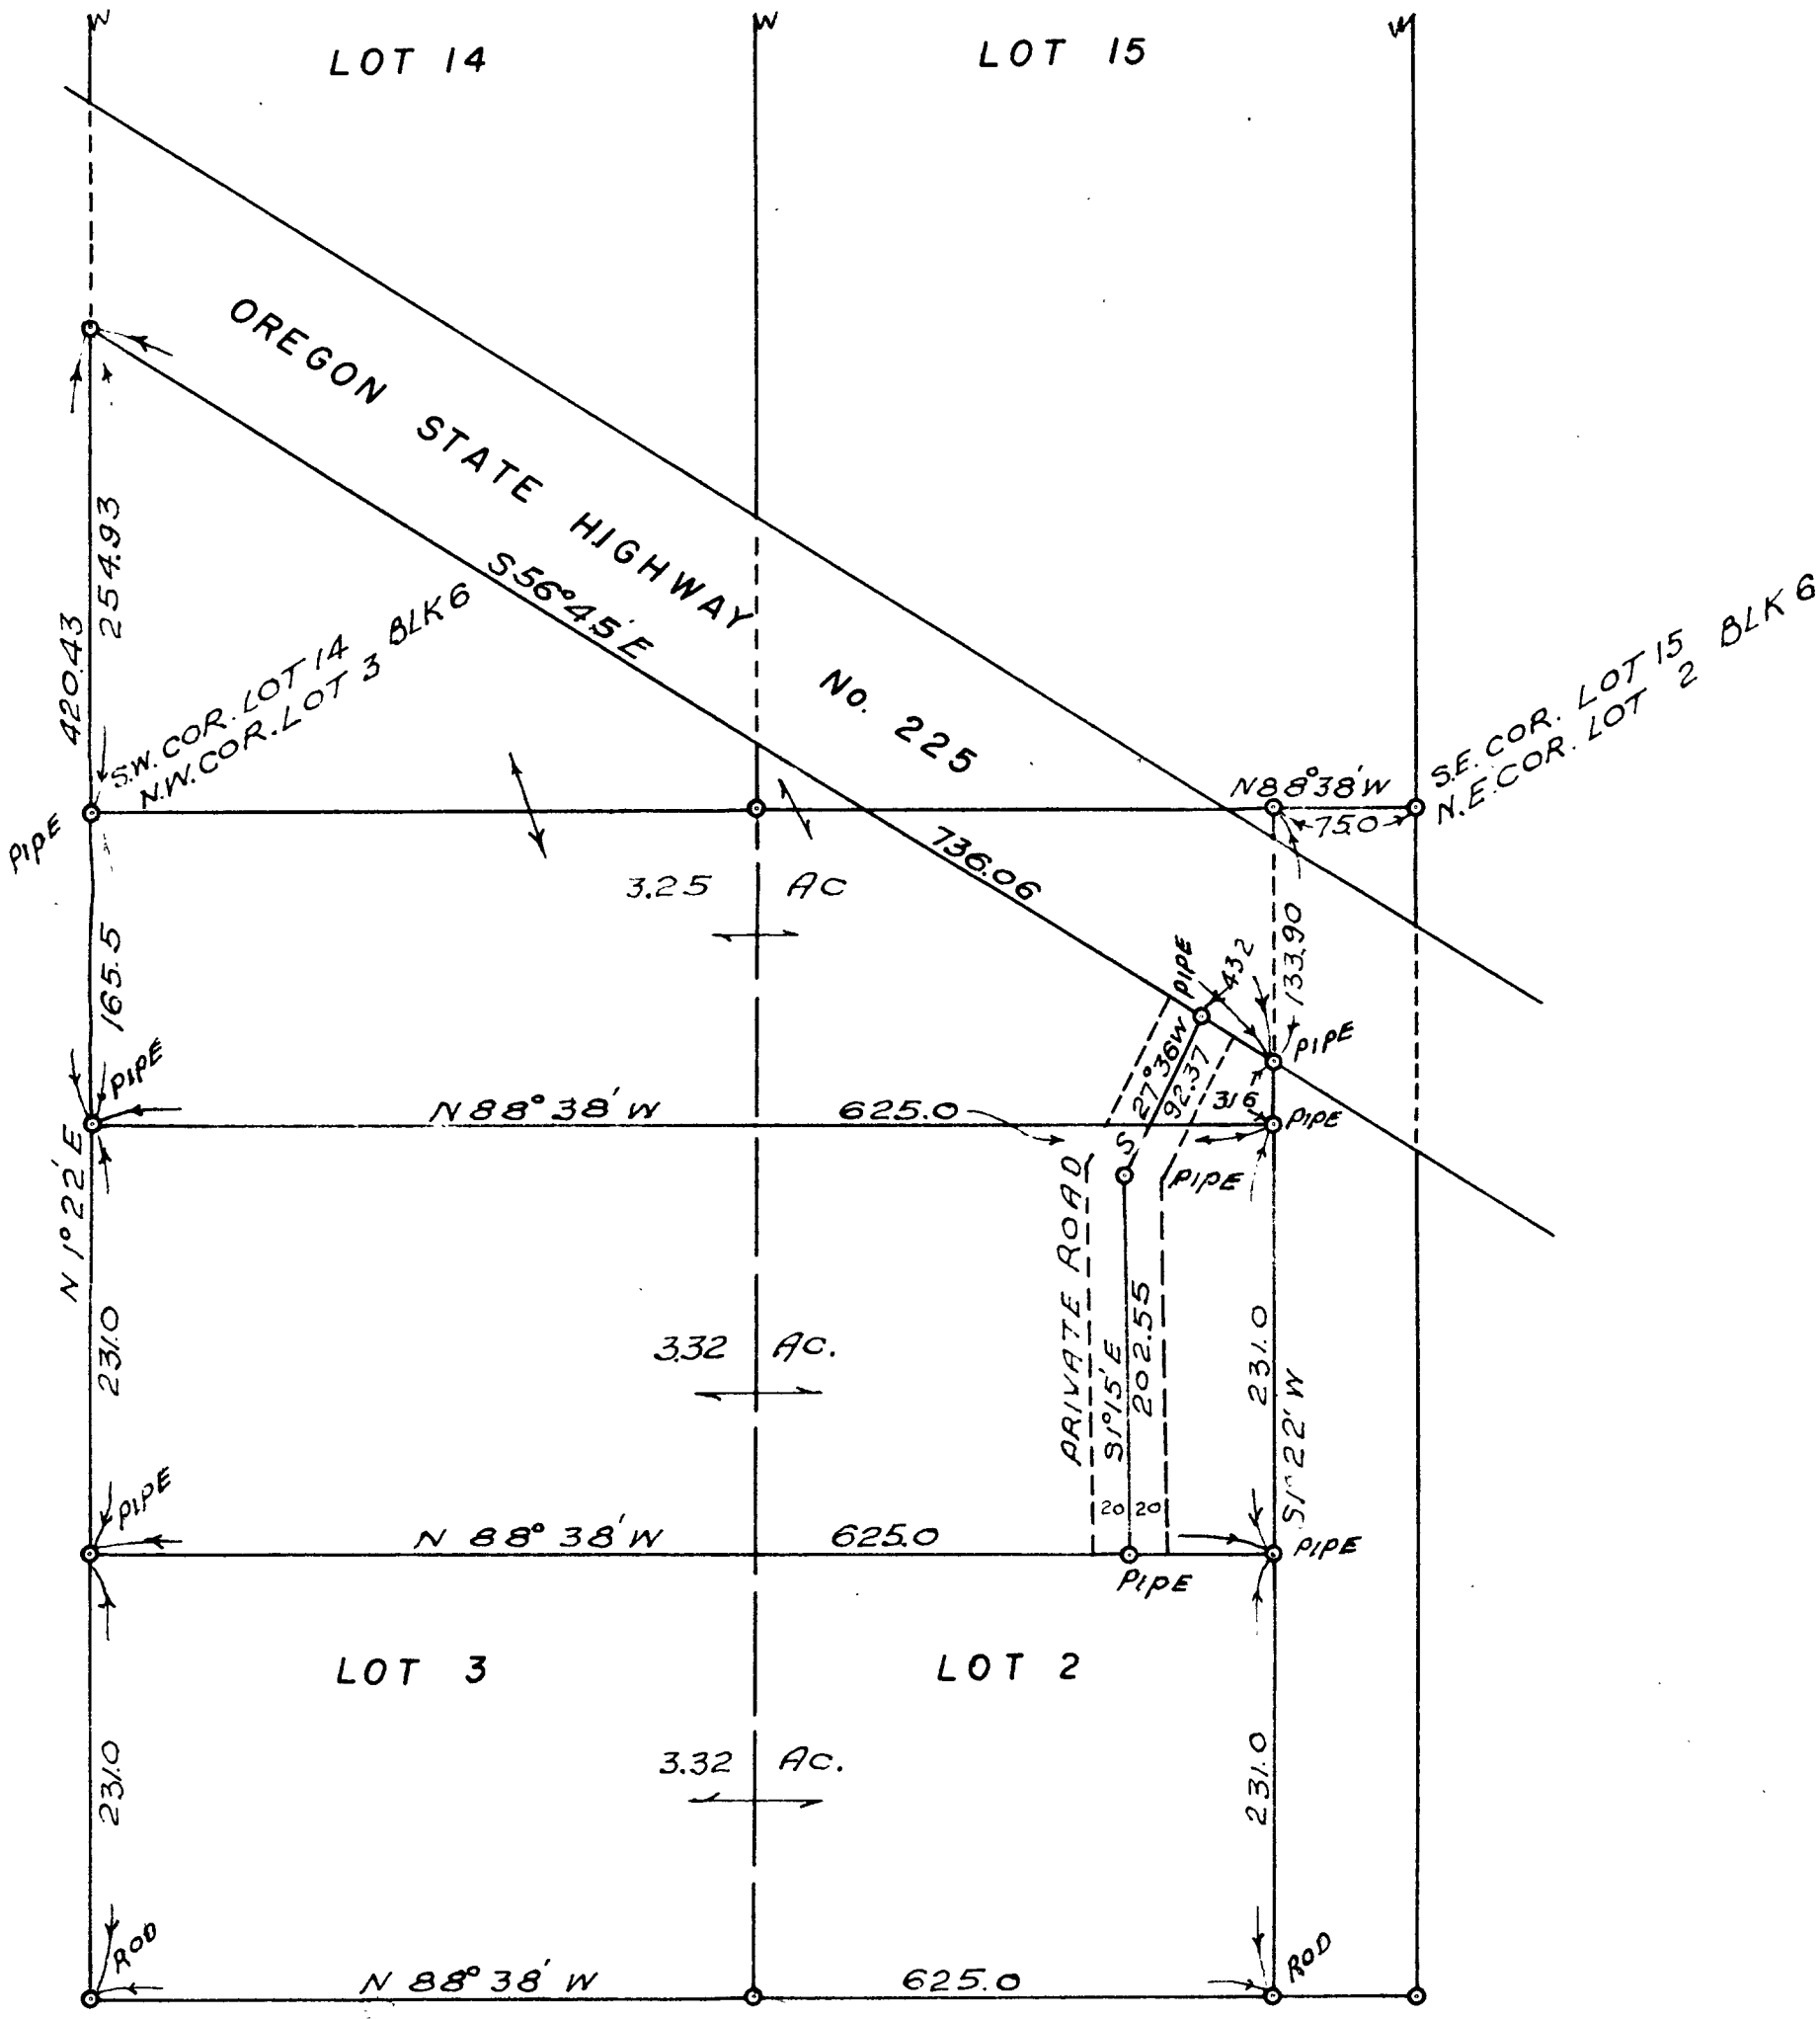

C. S. File No. 50/132