



LEO SMITH
 SUTHERLIN OREGON
 MARCH 1953 FRED L. DOW
 SCALE 1"=100' C.E.

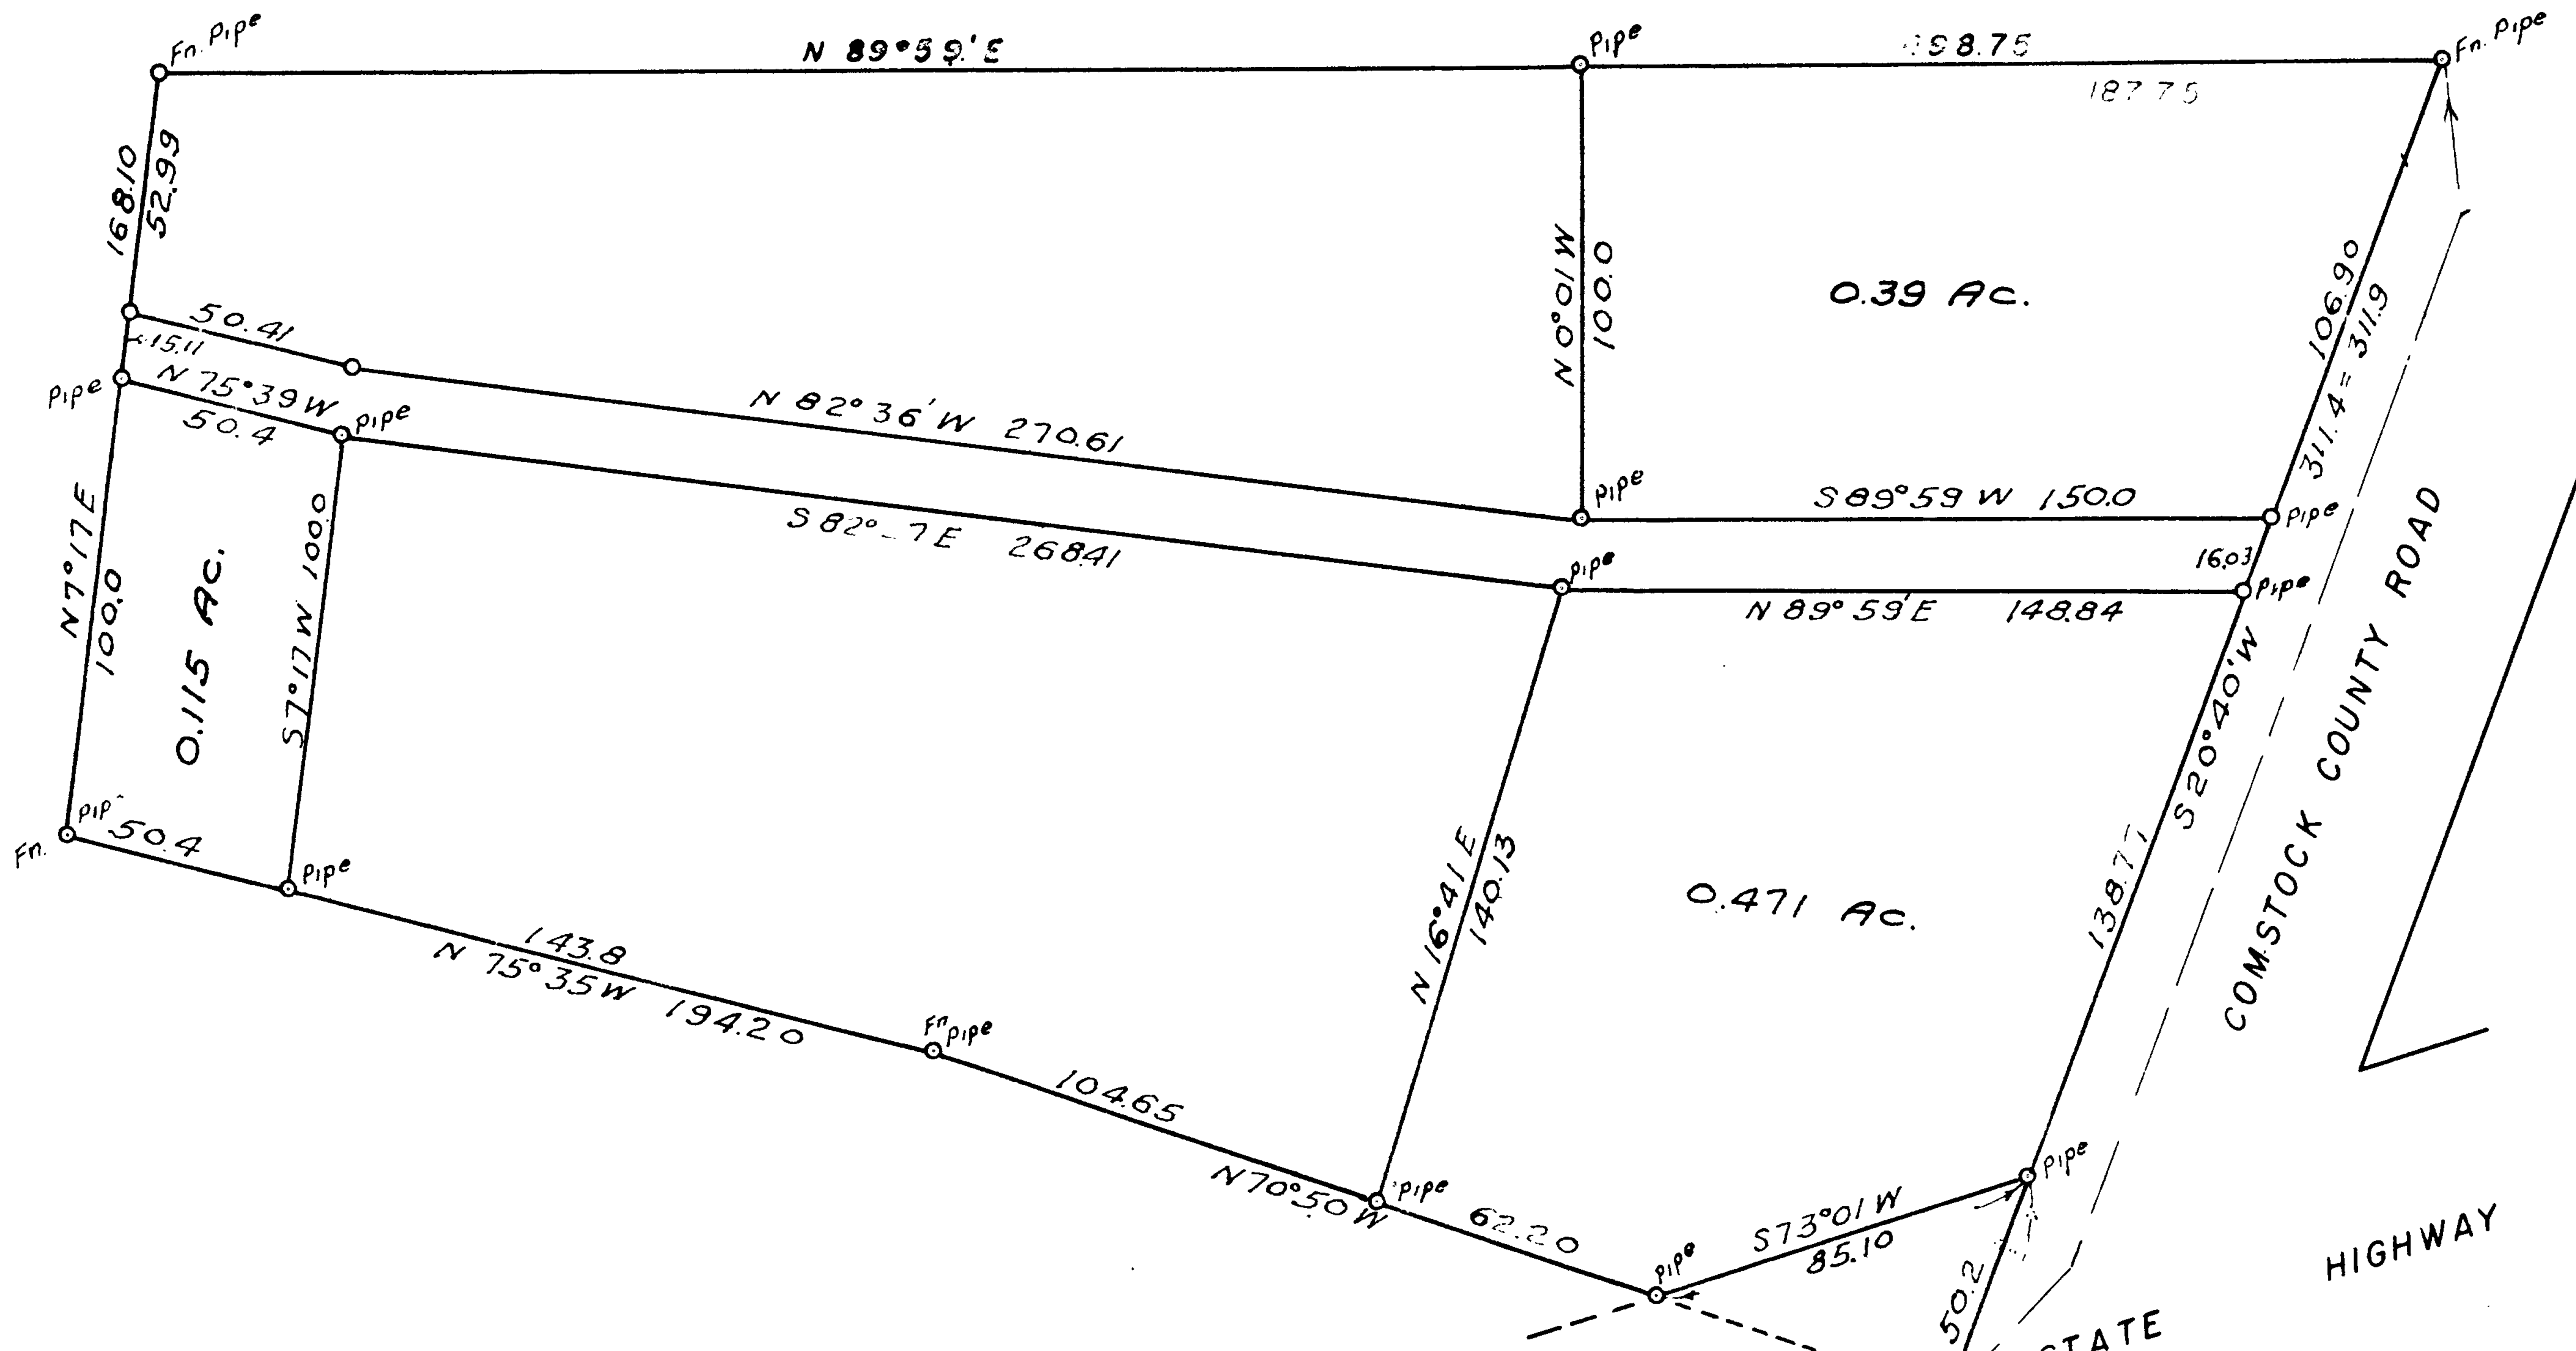

81 SW 113 028



LEO SMITH
 SUTHERLIN OREGON
 APRIL 1957 1" = 40'

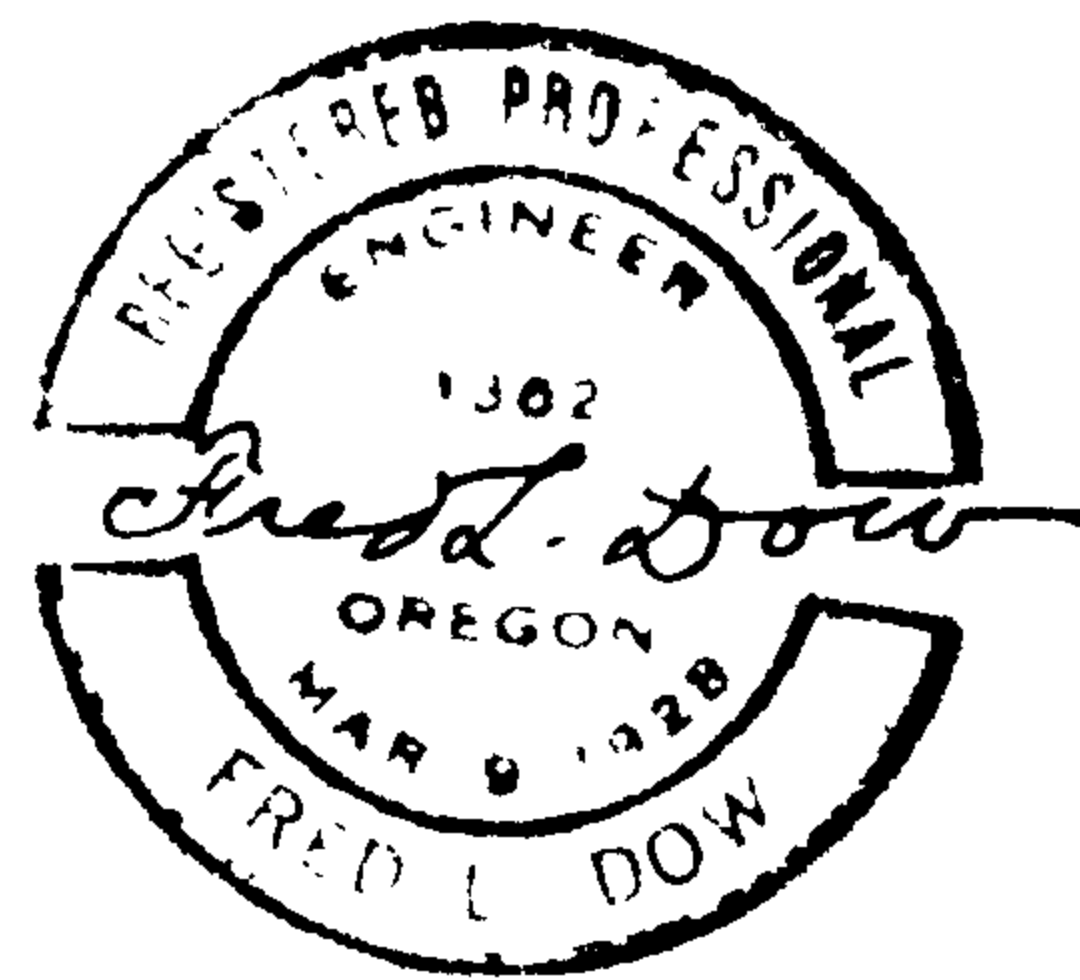

FILED
 RECEIVED

APR 8 1957

COUNTY SURVEYOR
 DEPT. OF AGRICULTURE

⊙ INITIAL POINT - PLAT "L"
 S. L. & W. Co.
 SEC. 19, T. 25 S. R. 5 W.