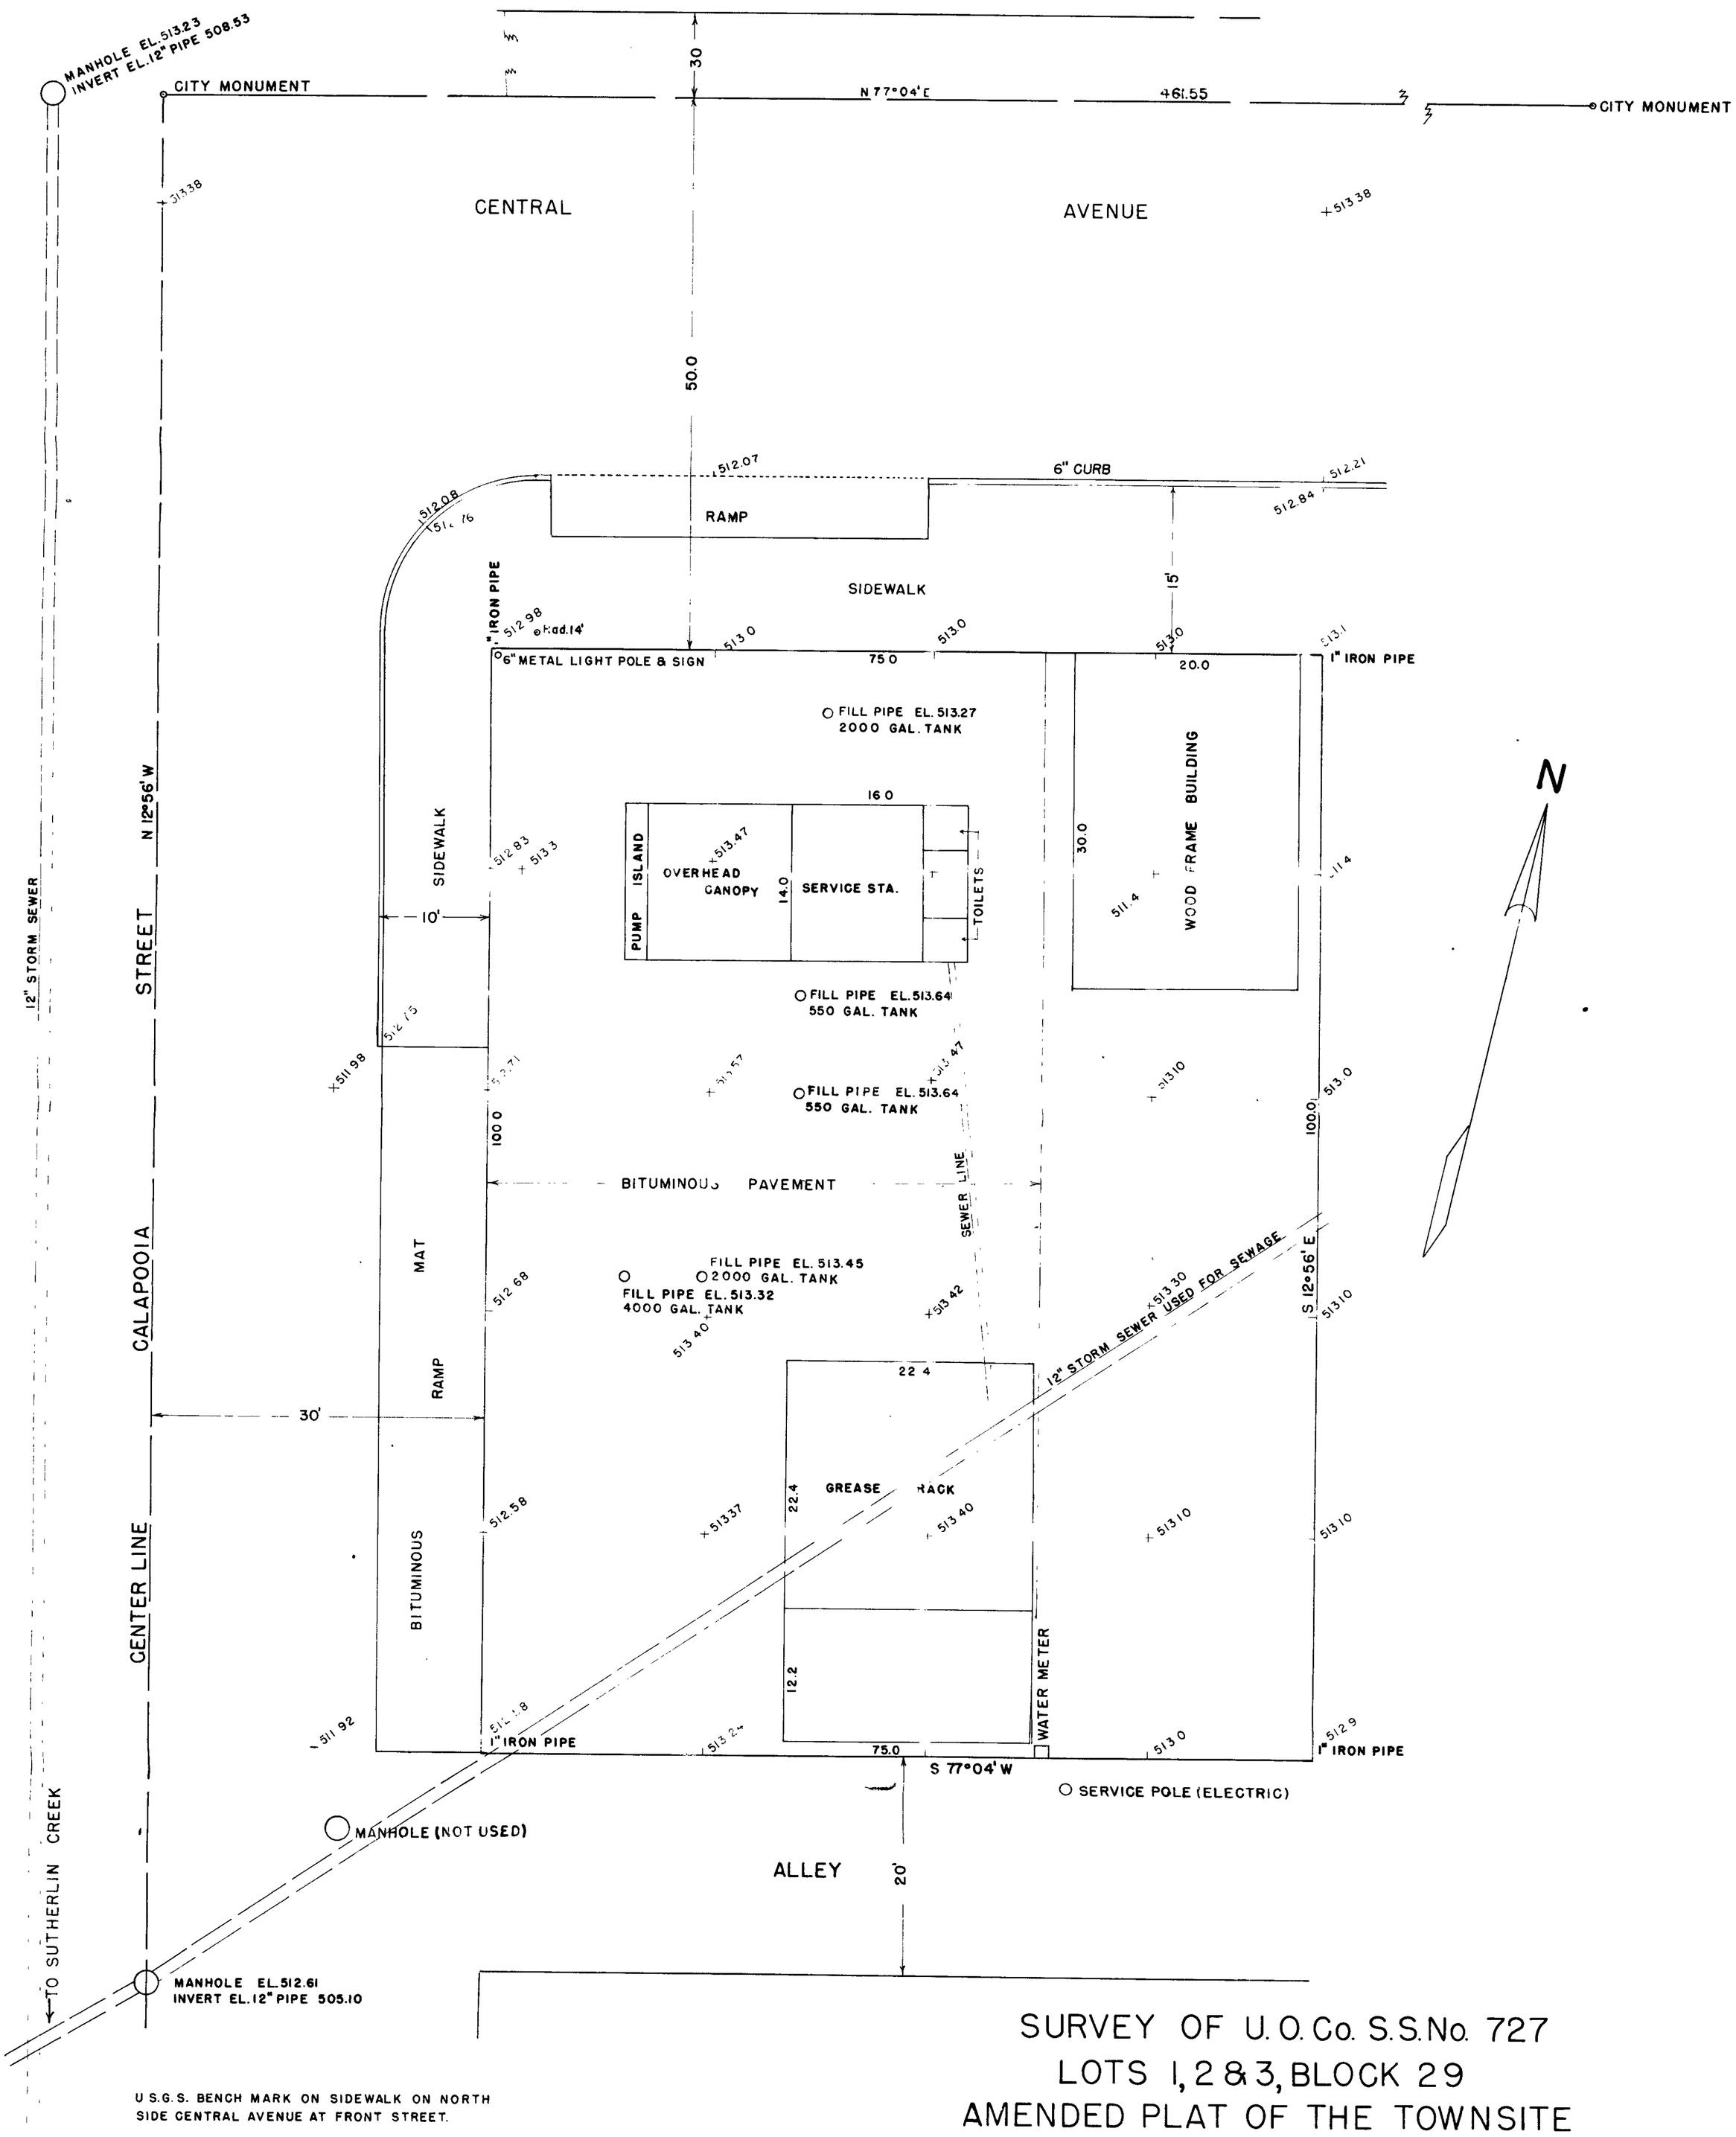

U.S.G.S. BENCH MARK ON SIDEWALK ON NORTH SIDE CENTRAL AVENUE AT FRONT STREET.

SURVEY OF U.O.Co. S.S.No. 727
LOTS 1, 2 & 3, BLOCK 29
AMENDED PLAT OF THE TOWNSITE OF SUTHERLIN
SUTHERLIN, OREGON. FEBRUARY, 53

SCALE 1/8" = 1'

Fred L. Dow
FRED L. DOW
REG. PROF. ENG. 1362