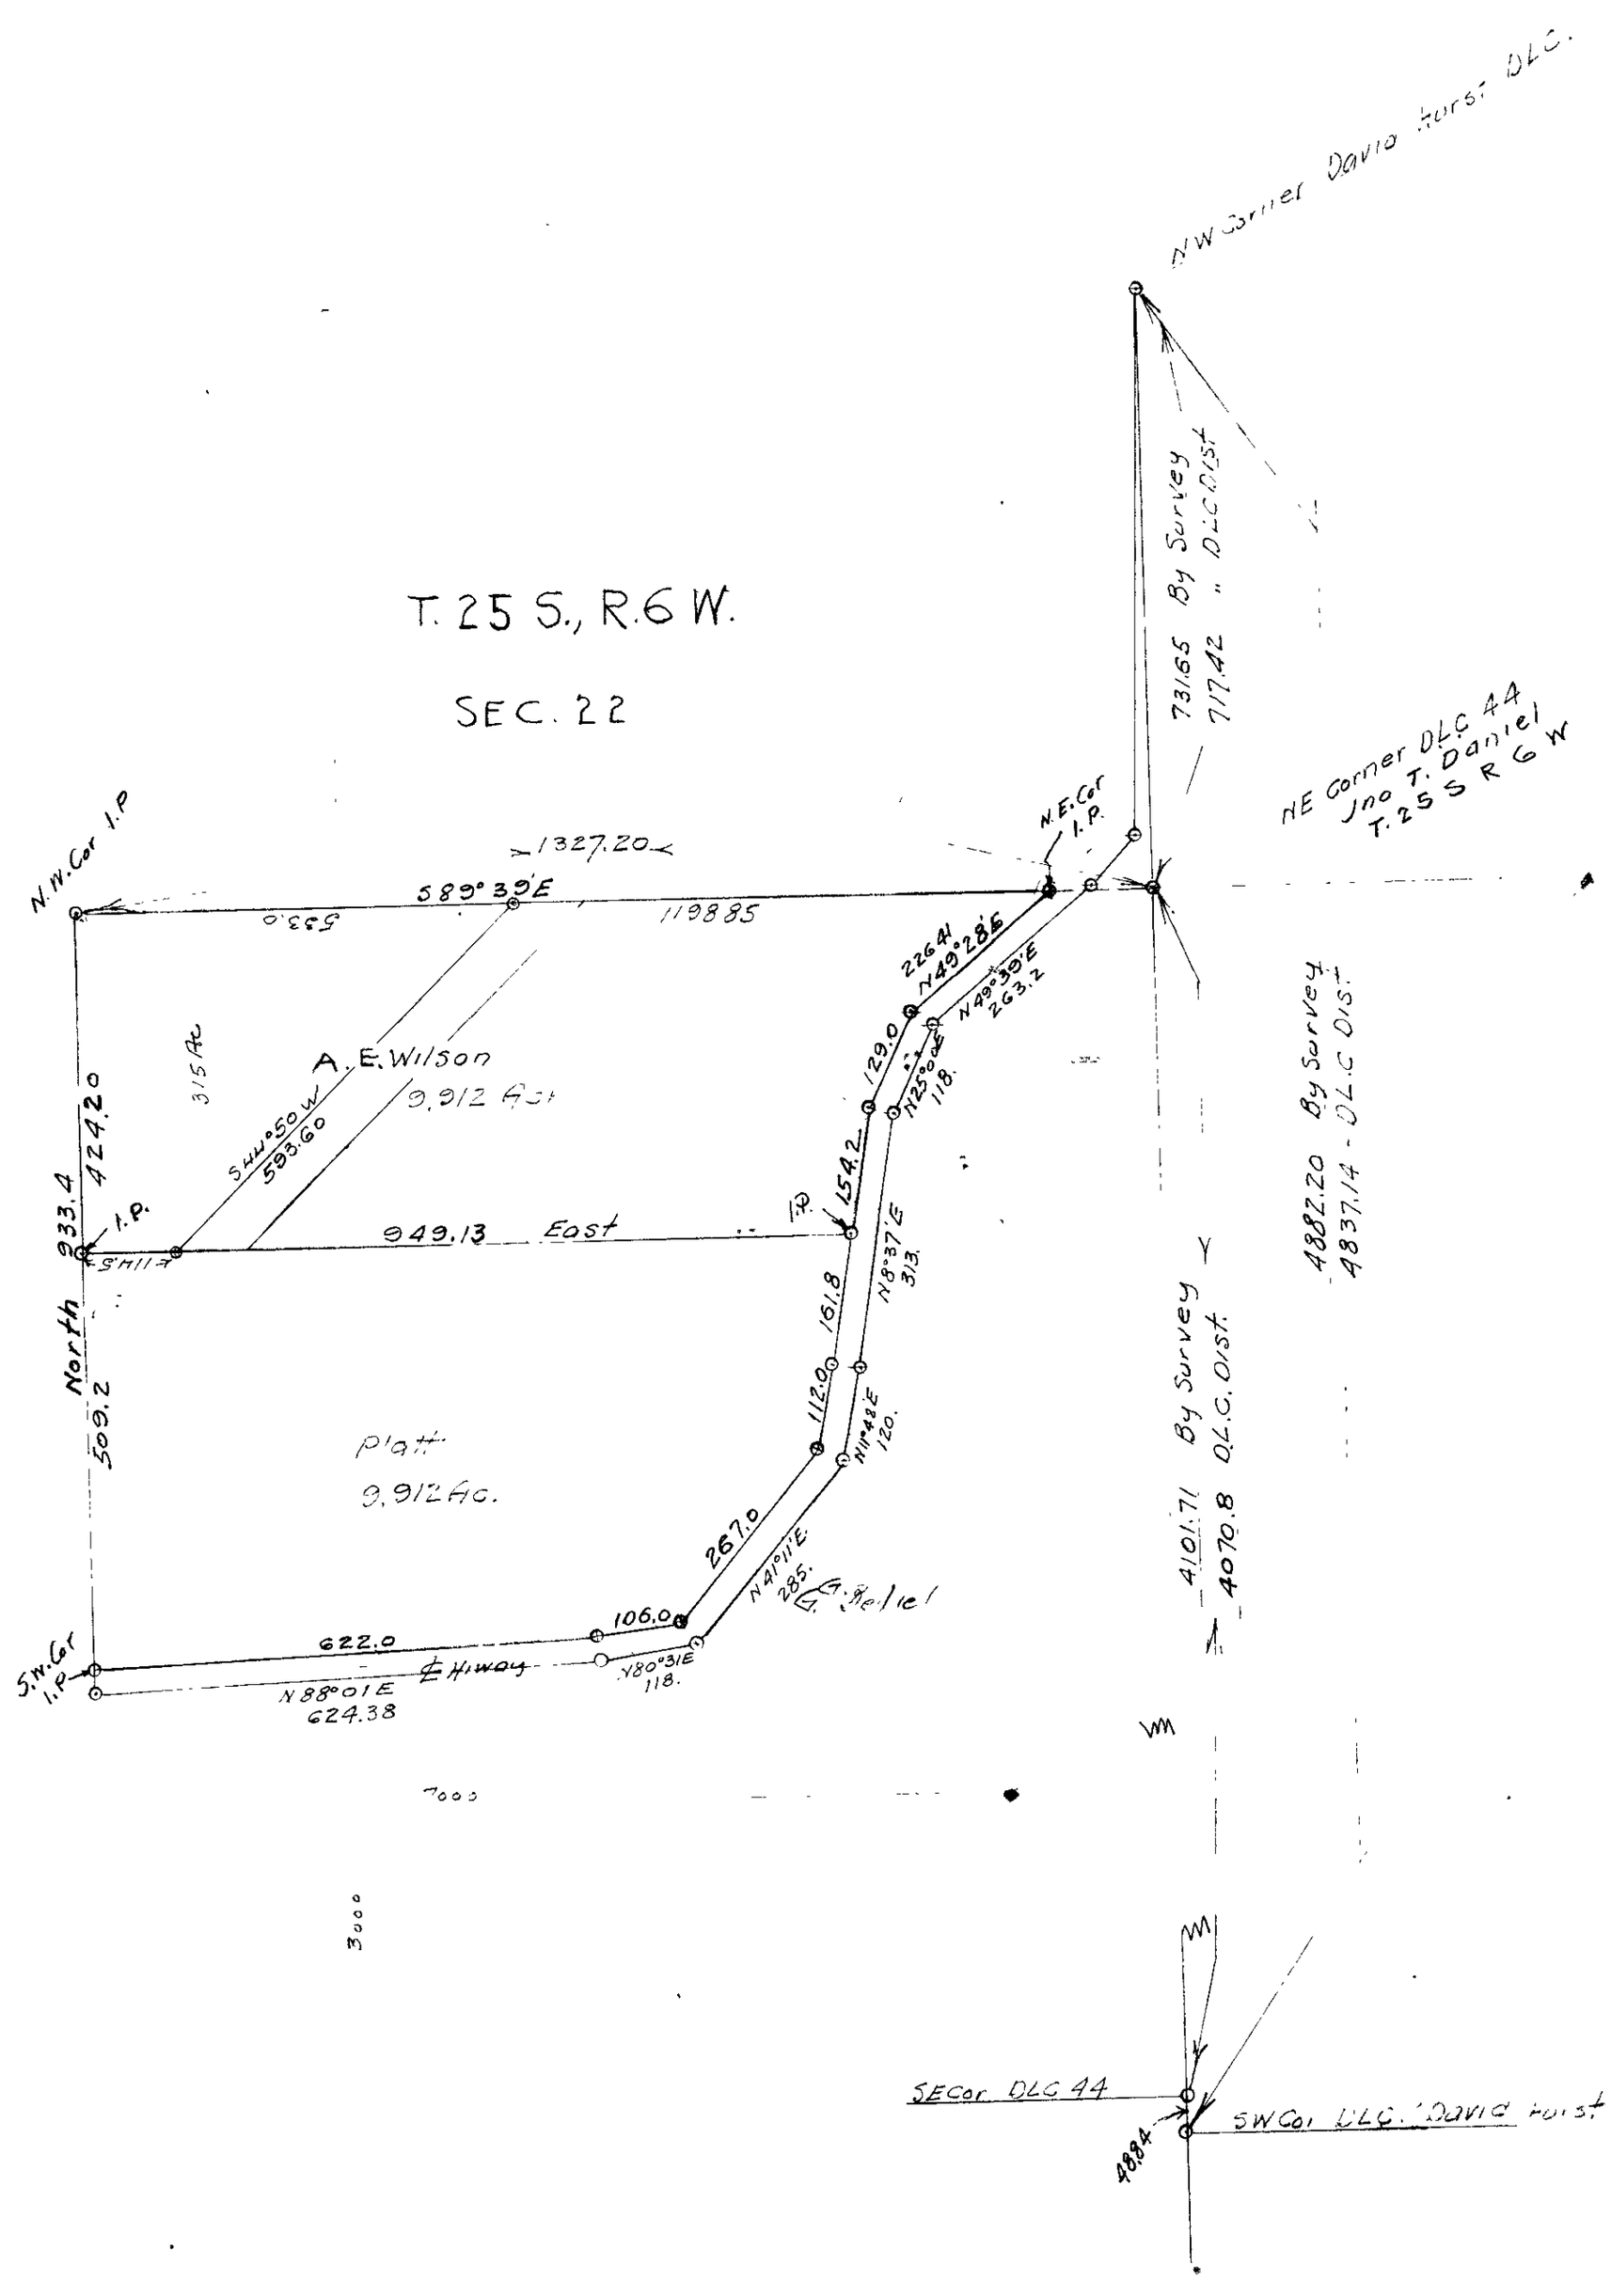
T. 25 S., R. 6 W.
SEC. 22
NW Corner David Hurst DLC.
By Survey " DLC Dist.
731.65
717.42
NE Corner DLC 44 Jno T. Daniel T. 25 S R 6 W
N.W. Cor I.P.
N.E. Cor I.P.
1327.20
S89°39'E
1198.85
533.0
315 Ac
A. E. Wilson
9.912 Ac
S44°50'W
593.60
2264
N49°28'E
N49°39'E
263.2
129.0
N23°00'E
118.
1542
949.13 East
933.4
424.20
I.P.
North
509.2
N8°37'E
313.
161.8
112.0
N11°48'E
120.
Plat
9.912 Ac.
267.0
N41°11'E
285.
106.0
622.0
N80°31'E
118.
S.W. Cor I.P.
N88°01'E
624.38
℄ Hiway
4882.20 By Survey
4837.14 - DLC Dist.
4101.71 By Survey
4070.8 DLC. Dist.
7000
3000
SE Cor DLC 44
SW Cor DLC. David Hurst
4884

C.S. 50/162