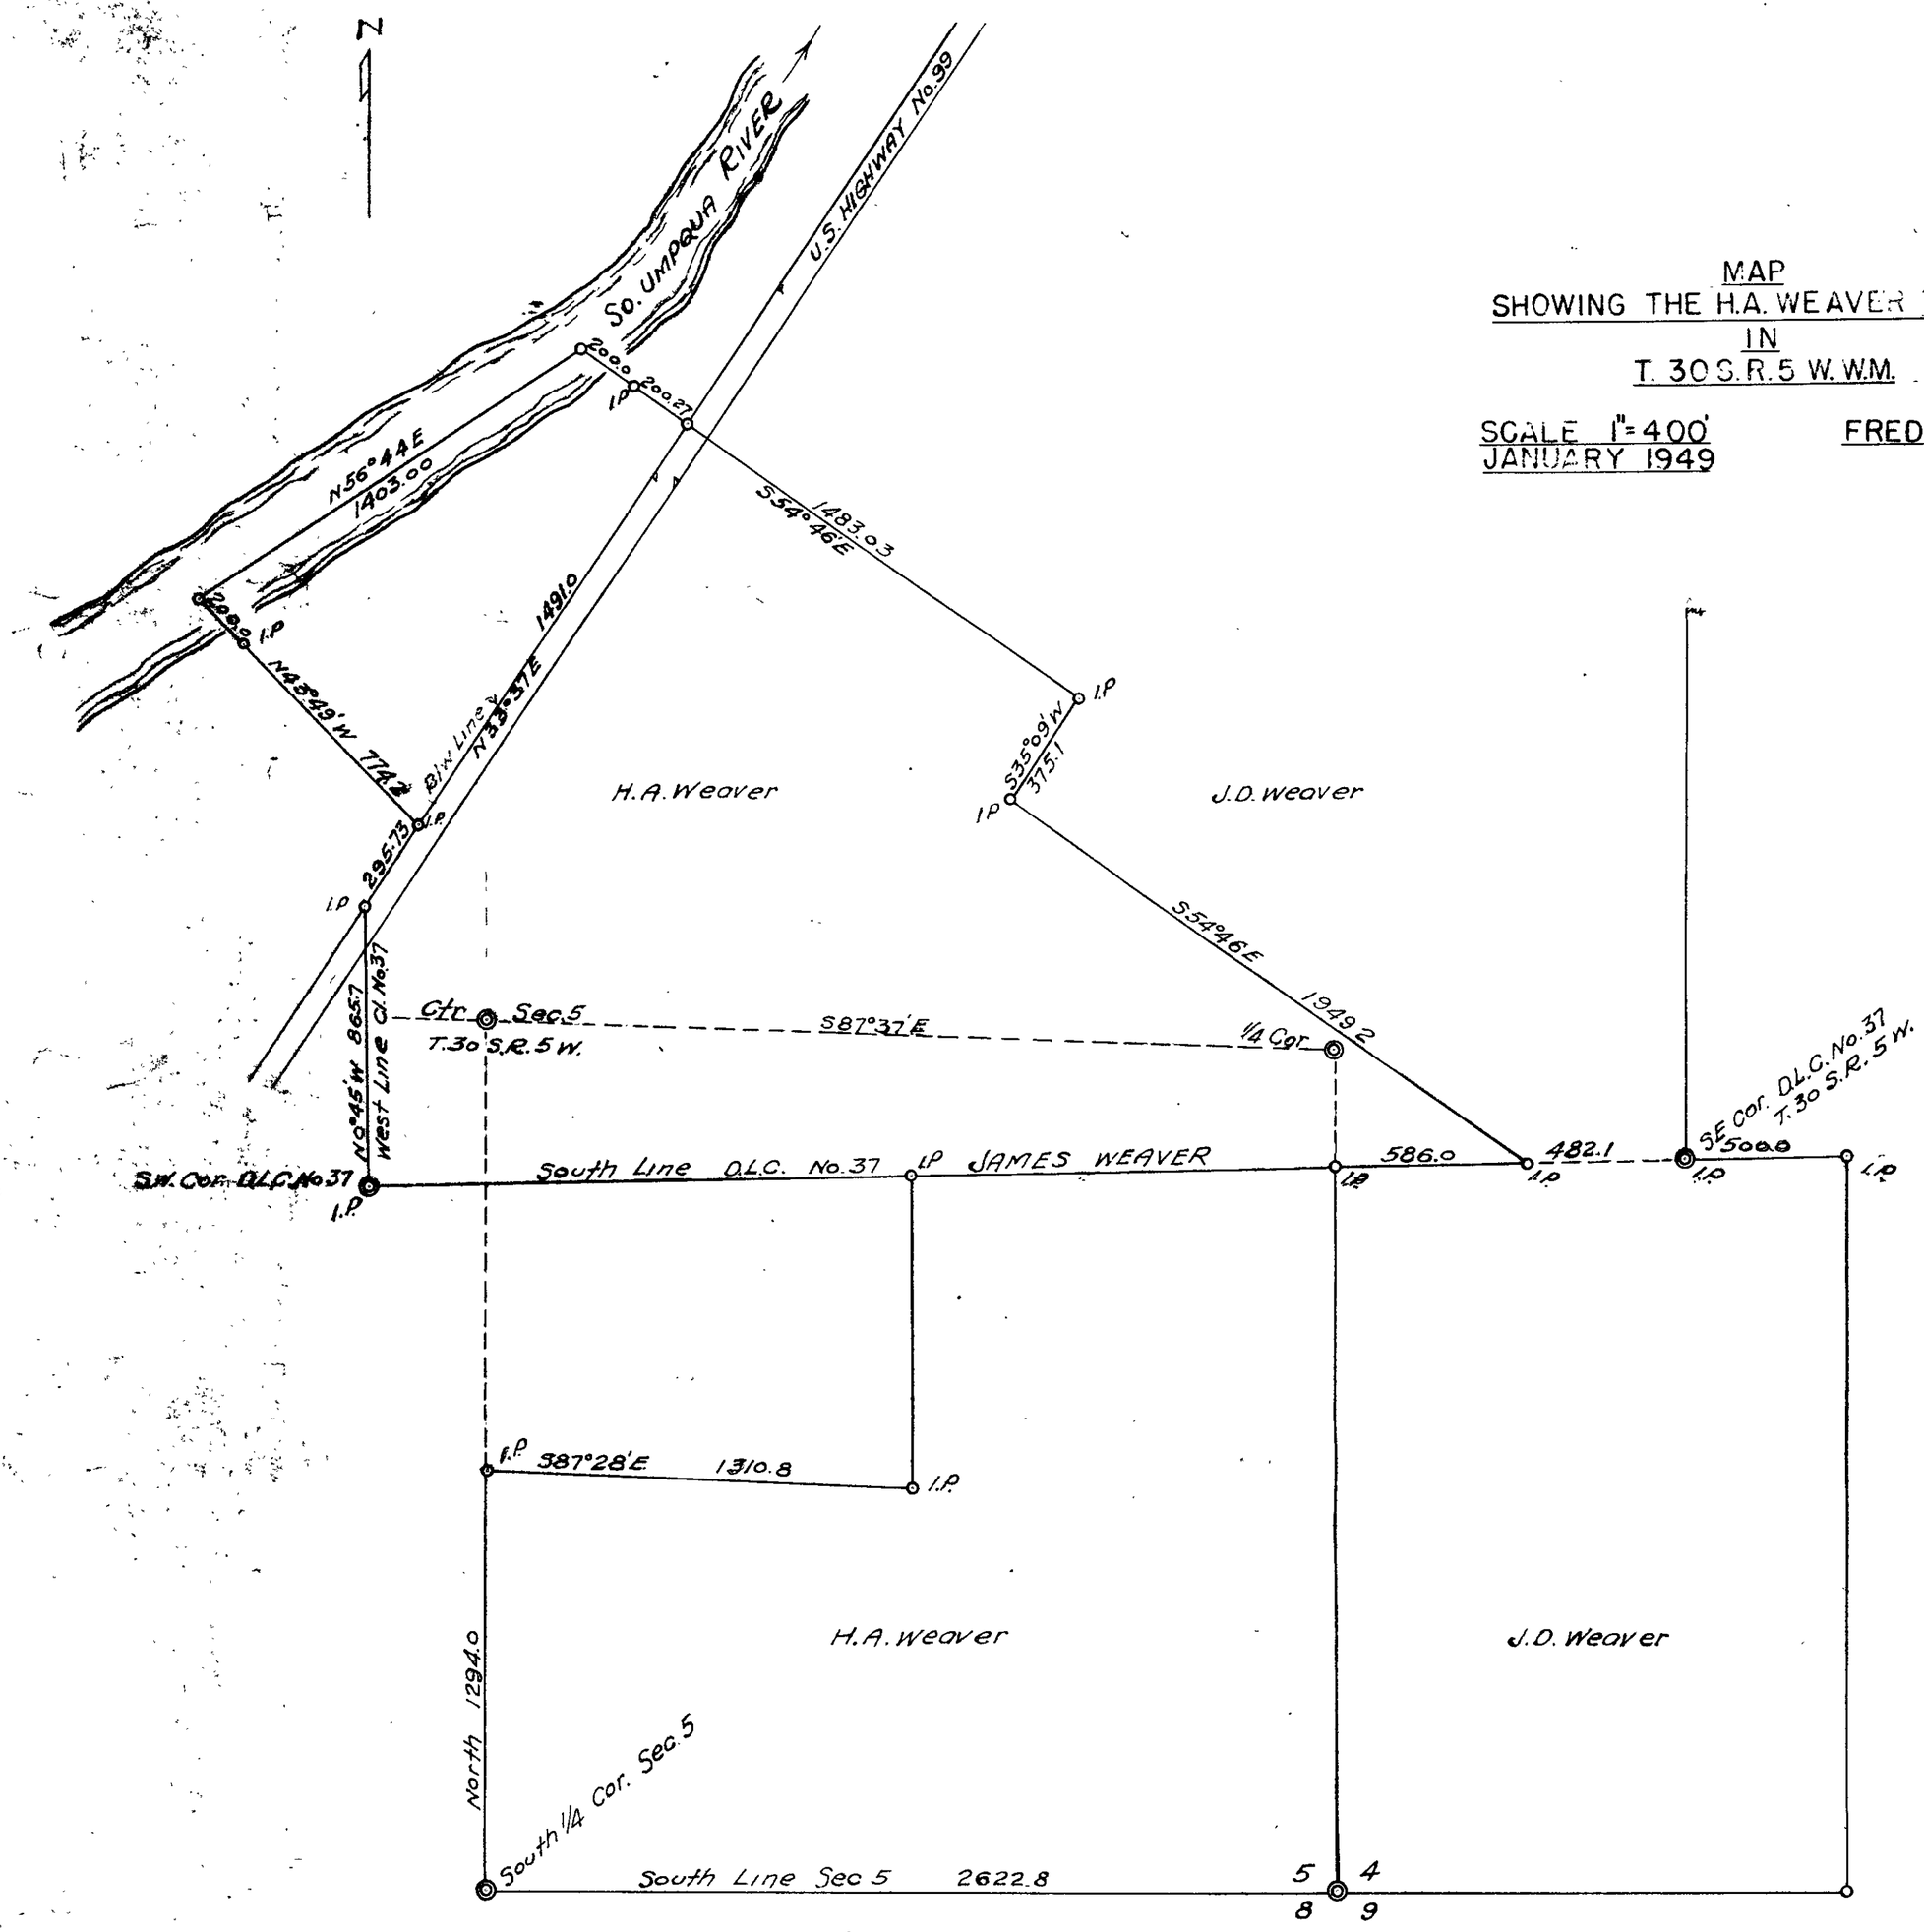

MAP
SHOWING THE H.A. WEAVER TRACT
IN
T. 30 S. R. 5 W. W.M.

SCALE 1" = 400'
JANUARY 1949

FRED L. DOW
CIV. ENG

CS 50/164
M 9-74