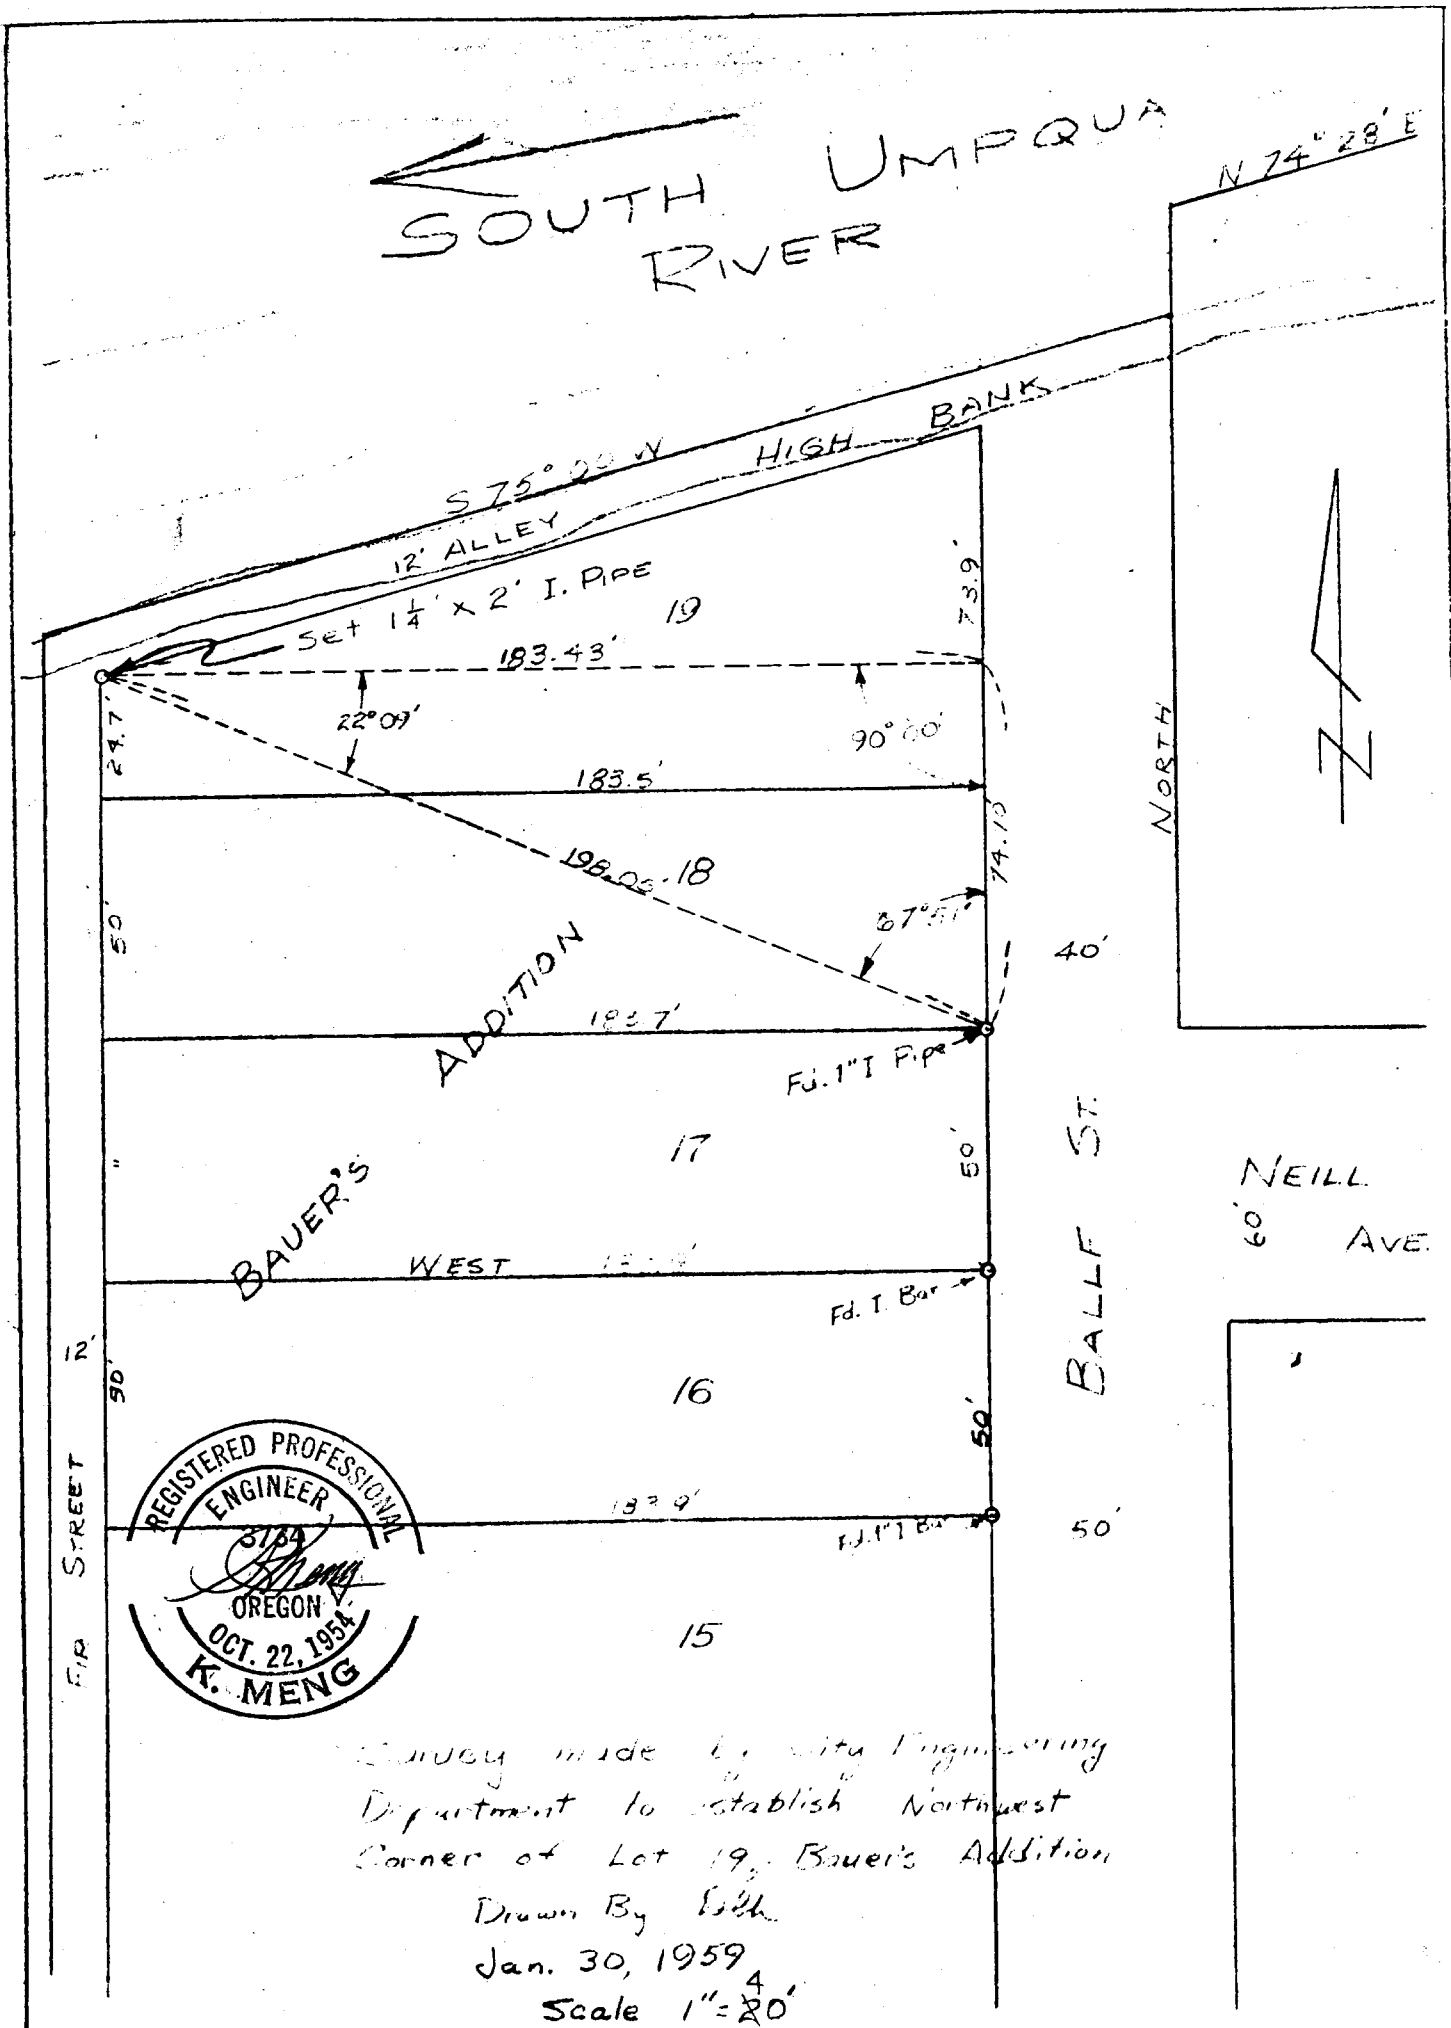

Survey made by City Engineering Department to establish Northwest Corner of Lot 19, Bauer's Addition

Drawn By [illegible]

Jan. 30, 1959

Scale 1" = 20'

CS 51/1