MAP
SHOWING CORNERS SET
LOT-25
SECOND EVERDINE HOME SITES
E½ LOT-12 FRUITVALE
ROSEBURG - DOUGLAS COUNTY OREGON.
Scale-1"=50' March 1959.

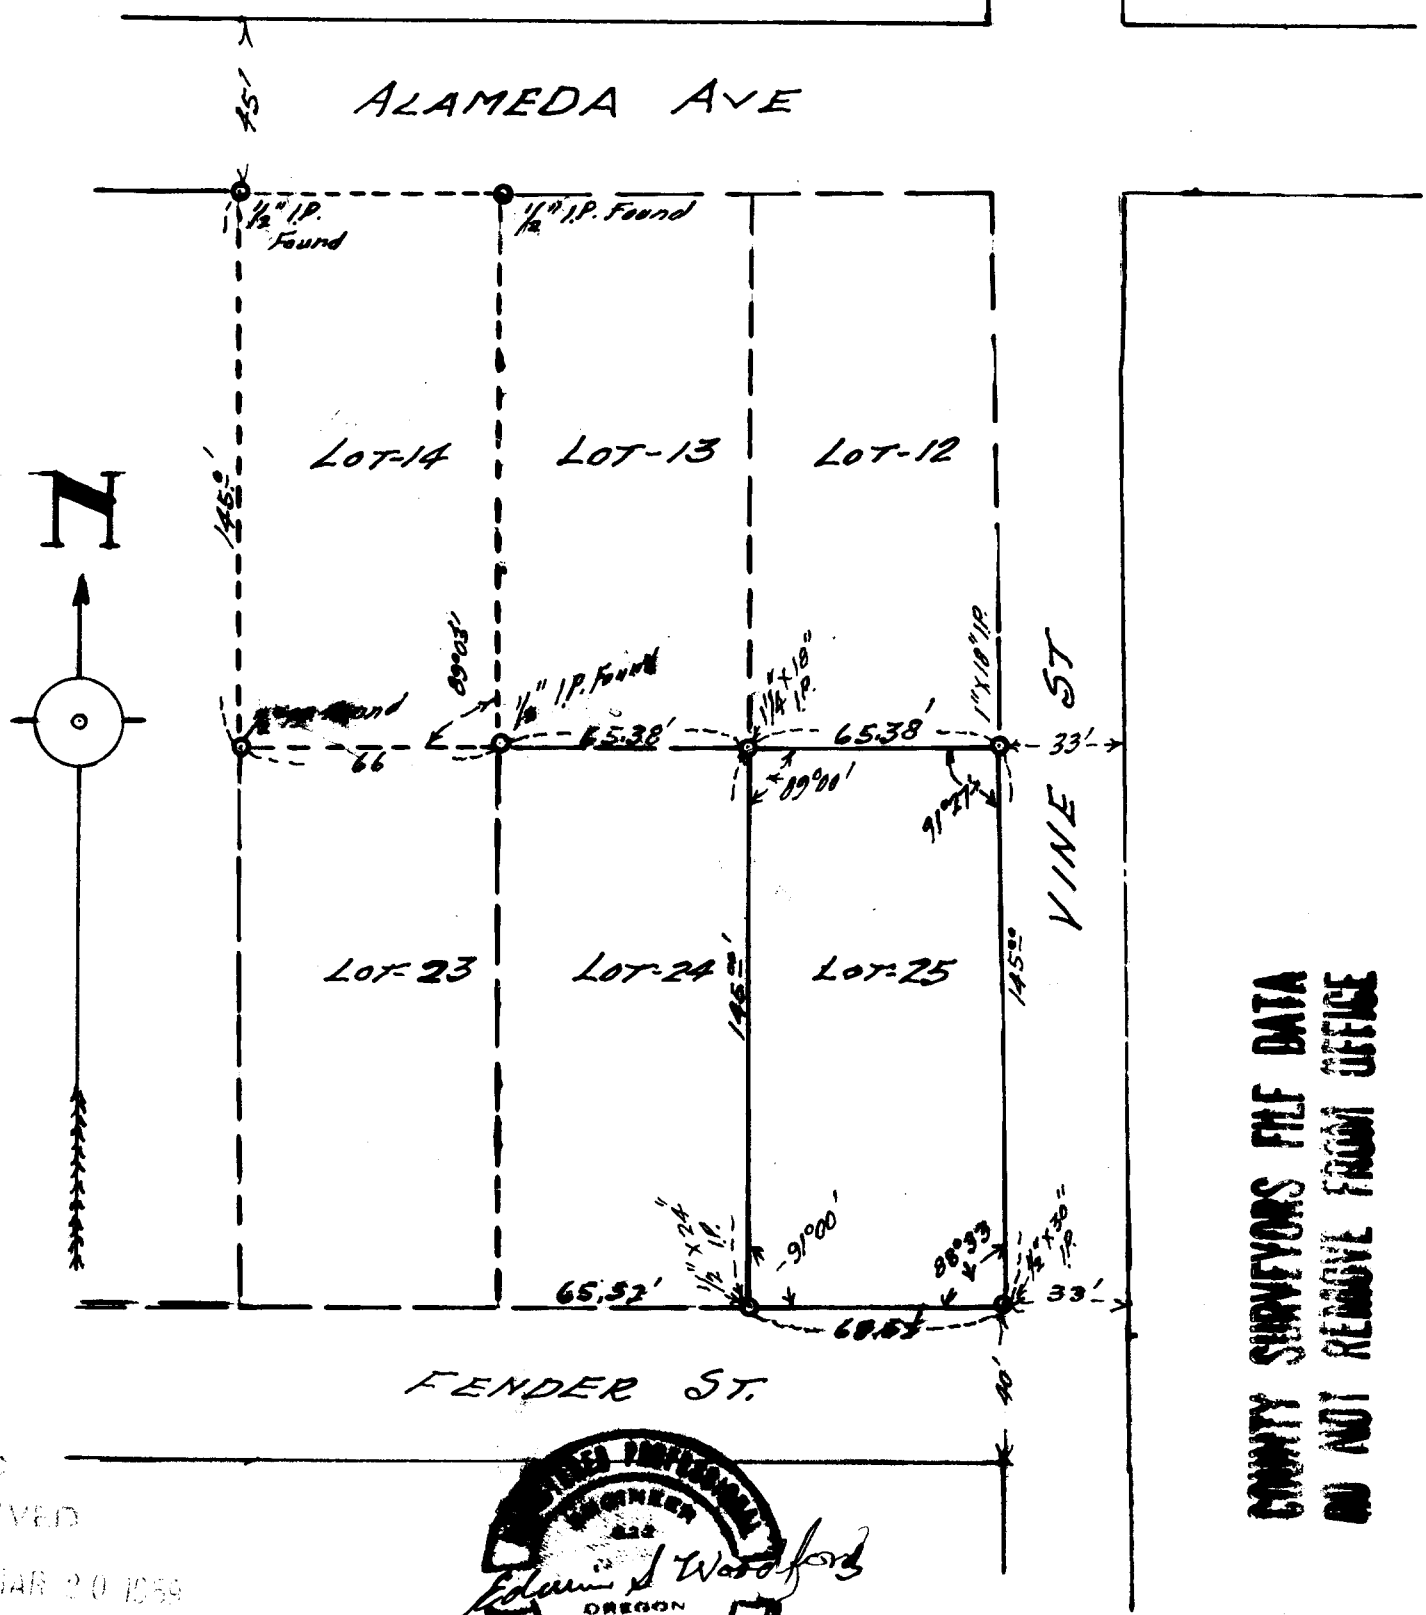

COUNTY SURVEYORS FILE DATA
DO NOT REMOVE FROM OFFICE

FILED
RECEIVED
MAR 20 1959
COUNTY SURVEYOR
DOUGLAS COUNTY, ORE.

REGISTERED PROFESSIONAL ENGINEER
Edwin A. Wardford
OREGON
DEC. 8, 1959

FOR DALE BLANCK

C. S. File No. 51/10