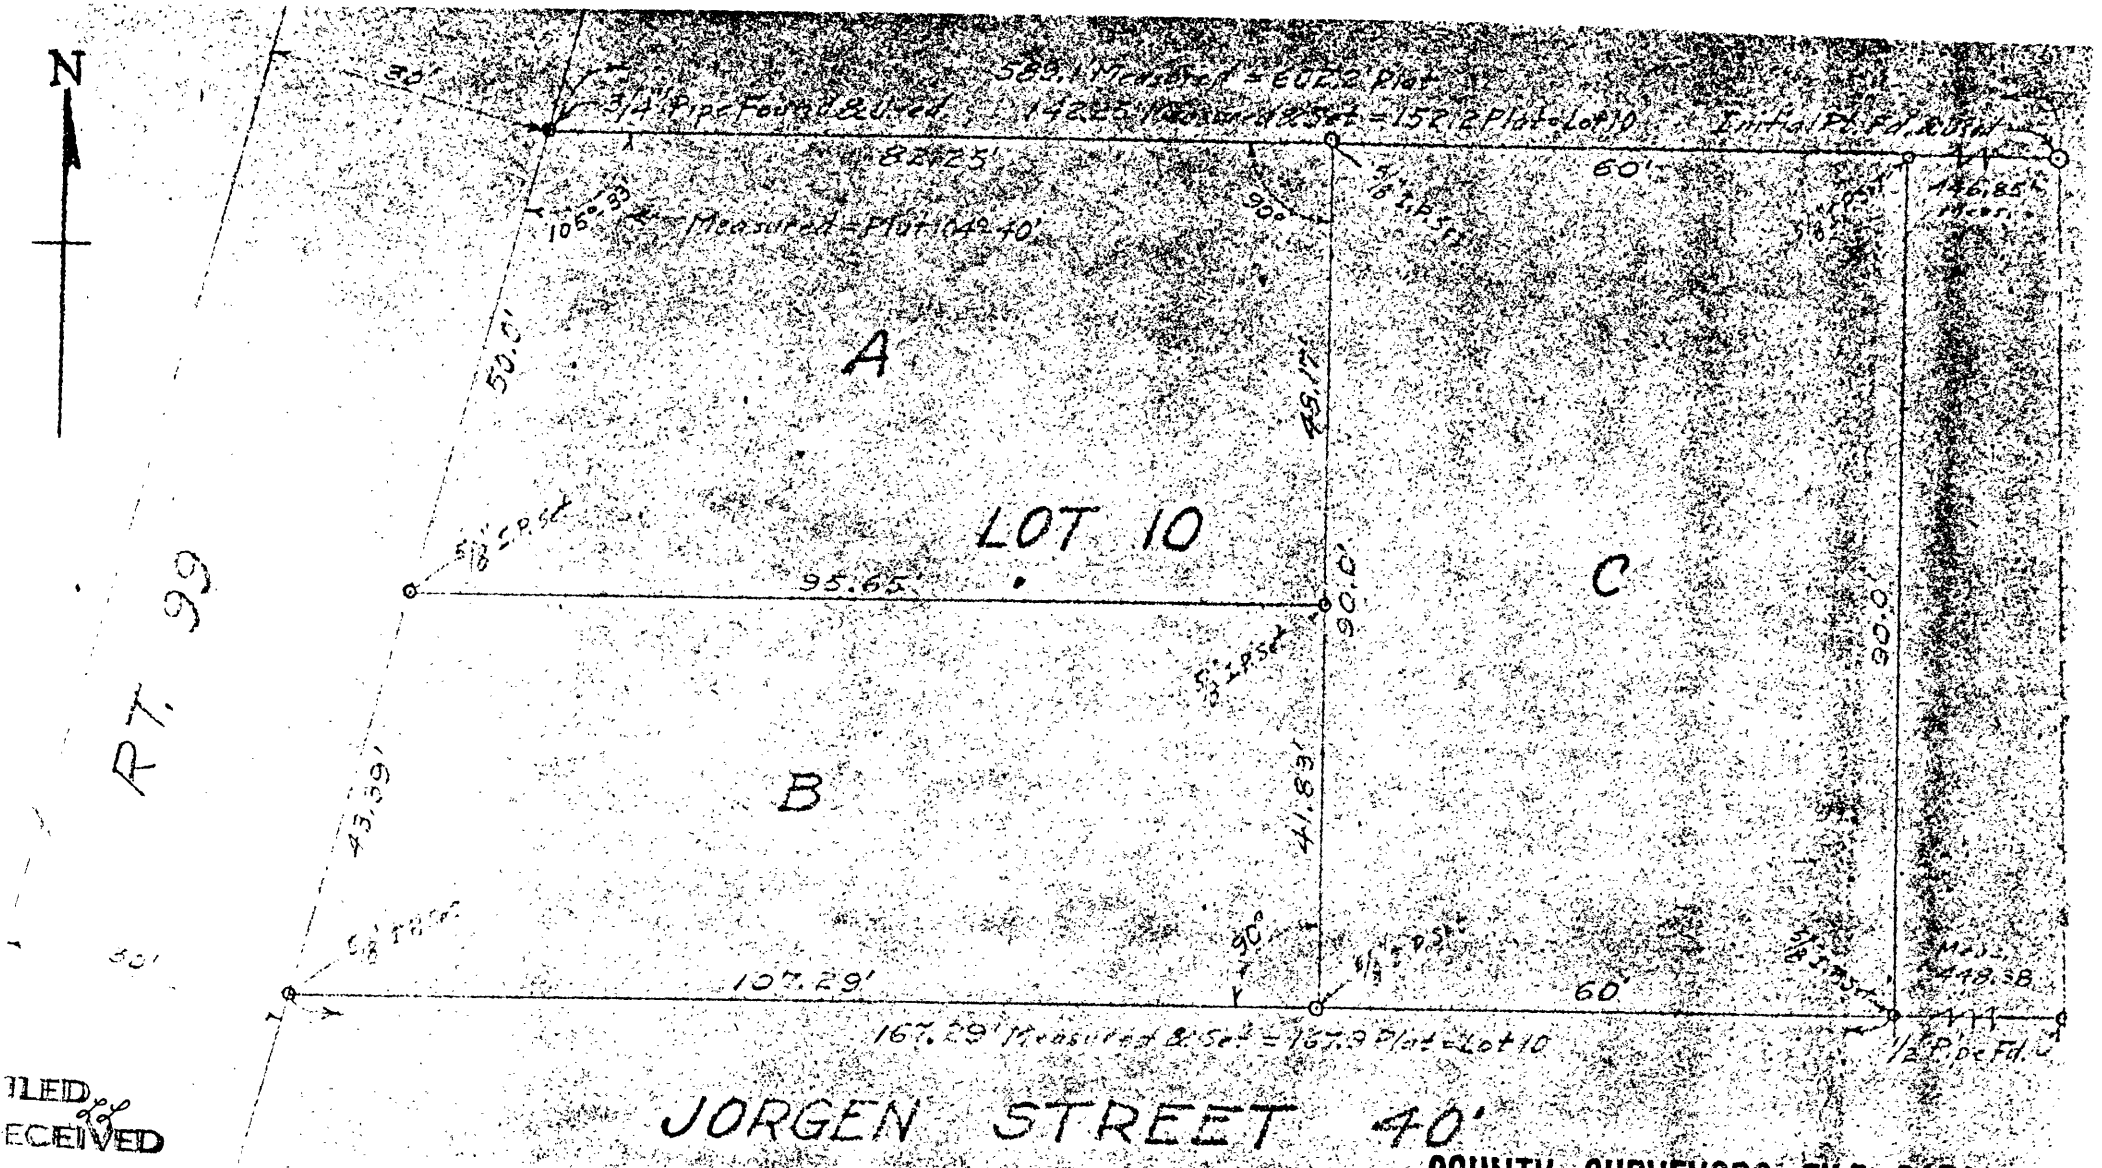

FILED
RECEIVED
APR 15 1959
COUNTY SURVEYOR
DOUGLAS COUNTY, ORE.

COUNTY SURVEYORS FILE DATA
DO NOT REMOVE FROM OFFICE

MAP OF SURVEY & SUBDIVISION LOT 10

JORGEN'S SUBDIVISION - WINSTON - OREGON

Made & Platted By

JAMES R. DAUGHERTY

CHAS. A. HARVEY ASSOC.

ROSEBURG OREGON

SCALE 1" = 20'

APR. 1952.

REGISTERED PROFESSIONAL ENGINEER
2359
James R. Daugherty
OREGON
NOV. 10, 1944
JAMES R. DAUGHERTY