

T 21 S R 6 W Sects 3 + 4

At $\frac{1}{4}$ S. cor. $\frac{3}{4}$ found rock with
X and Both old B.Ts.

Both dead .

Set 1" x 1" x 36" T iron
Attached cap $1\frac{1}{16}$ " diam inscribed
survey point - Wilford N. HAINES # 239
Drain, Oregon,

Scribed New B.Ts.

48" fir S 53° E 50.9 ft

26" fir N 49° 22' E. 185.3 ft.


FILED
RECEIVED

JUN 25 1959

COUNTY SURVEYOR
DOUGLAS COUNTY, ORE.



Wilford N. Haines

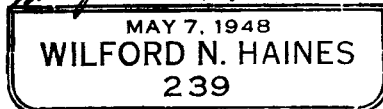

Corner # 32-A ✓ ✓

C. S. File No.

51/37³

Sect. 3/4 - T. 21 S., R. 6 W.
N 1/2

EAST WEST

4/3	50°30'W	186.52	1.63	186.52 - 1.63	+ 2.21	3.84
1	S9°48'W	289.17	49.95	475.69 - 51.58	+ 5.64	57.22
2	S4°03'E	108.01	7.65	583.70 - 43.93	+ 6.92	50.85
3	S12°33'E	201.23	44.79	784.93 + 0.86	+ 9.30	8.44
4	S3°25'W	132.63	7.92	917.56 - 7.06	+ 10.87	17.93
5	S8°02'W	198.27	28.28	1115.83 - 35.34	+ 13.22	48.56
6	S1°15'E	59.36	1.29	1175.19 - 34.05	+ 13.92	47.97
7	S18°52'W	65.35	14.93	1240.54 - 48.98	+ 14.70	63.68
8	S6°47'E	243.16	28.92	1483.70 - 20.06	+ 17.58	37.64
9	S20°48'E	69.59	26.43	1553.29 + 6.37	+ 18.40	12.03
10	S0°23'E	254.16	1.70	1807.45 + 8.07	+ 21.42	13.34
11	S1°19'E	360.40	8.28	2167.85 + 16.35	+ 25.69	9.34
12	S4°23'W	168.81	12.94	2338.66 + 3.41	+ 27.69	24.28
13	S16°26'E	117.91	34.78	2454.57 + 38.19	+ 29.08	9.11
14	S16°47'E	469.97	141.74	2924.54 + 179.93	+ 34.65	145.29
15	S45°03'W	143.33	143.58	3067.87 + 36.35	+ 36.35	
4	N45°45'E	143.33	143.58	TAN = 0.1194 8611 SODIIE 3069.88		
15	S7°21'W	2871	293			
4	N49°22'E	185.3	140.65			

B.T. 26' D. fir

BT 48" D. fir S53°E. 50.9 ft

sect $\frac{3}{4}$ - T. 21 S., R. 6 W.
S $\frac{1}{2}$

East West

17	S 11° 00' W	316.89	311.07	60.47	265.18 + 174.88	- 3.94	
18	S 12° 21' W	193.00	178.50	73.39	576.25 + 114.41	- 8.57	
19	S 15° 35' W	308.62	297.28	82.91	754.75 + 41.02	- 11.23	
20	S 17° 44' W	173.68	165.43	52.90	1052.03 - 41.89	- 15.65	26.24
21	S 2° 48' E	441.30	440.78	21.52	4217.46 - 94.79	- 18.12	76.67
22	S 2° 40' E	384.36	383.94	17.88	1658.24 - 73.27	- 24.67	48.60
23	S 3° 14' W	129.33	129.12	7.29	2042.18 - 55.39	30.39	25.00
24	S 1° 35' E	121.53	121.48	3.36	2171.30 - 62.68	- 32.31	30.35
25	S 7° 10' E	90.70	89.99	11.32	2292.78 - 59.32	- 34.12	24.20
26	S 4° 16' W	67.72	67.53	5.04	2382.77 - 48.00	- 35.46	12.54
27	S 6° 14' E	69.55	69.14	7.55	2450.30 - 53.04	- 36.46	16.58
28	S 4° 03' E	94.29	94.05	6.66	2519.44 - 45.48	- 37.49	8.00
29	S 0° 55' W	52.56	52.55	.84	2613.49 - 38.83	- 38.89	10.06
$\frac{413}{910}$					2666.04 - 39.67	39.67	

TAN = 14879746

S 0° 51' W 2666.33