MAP
OF
NEILE KASER PROPERTY
IN
LOT 44 PETER BALLF TRACT.
Sec. 24 TP. 27S - RG. 6 W WM.
Scale - 1" = 60' APRIL - 1956.

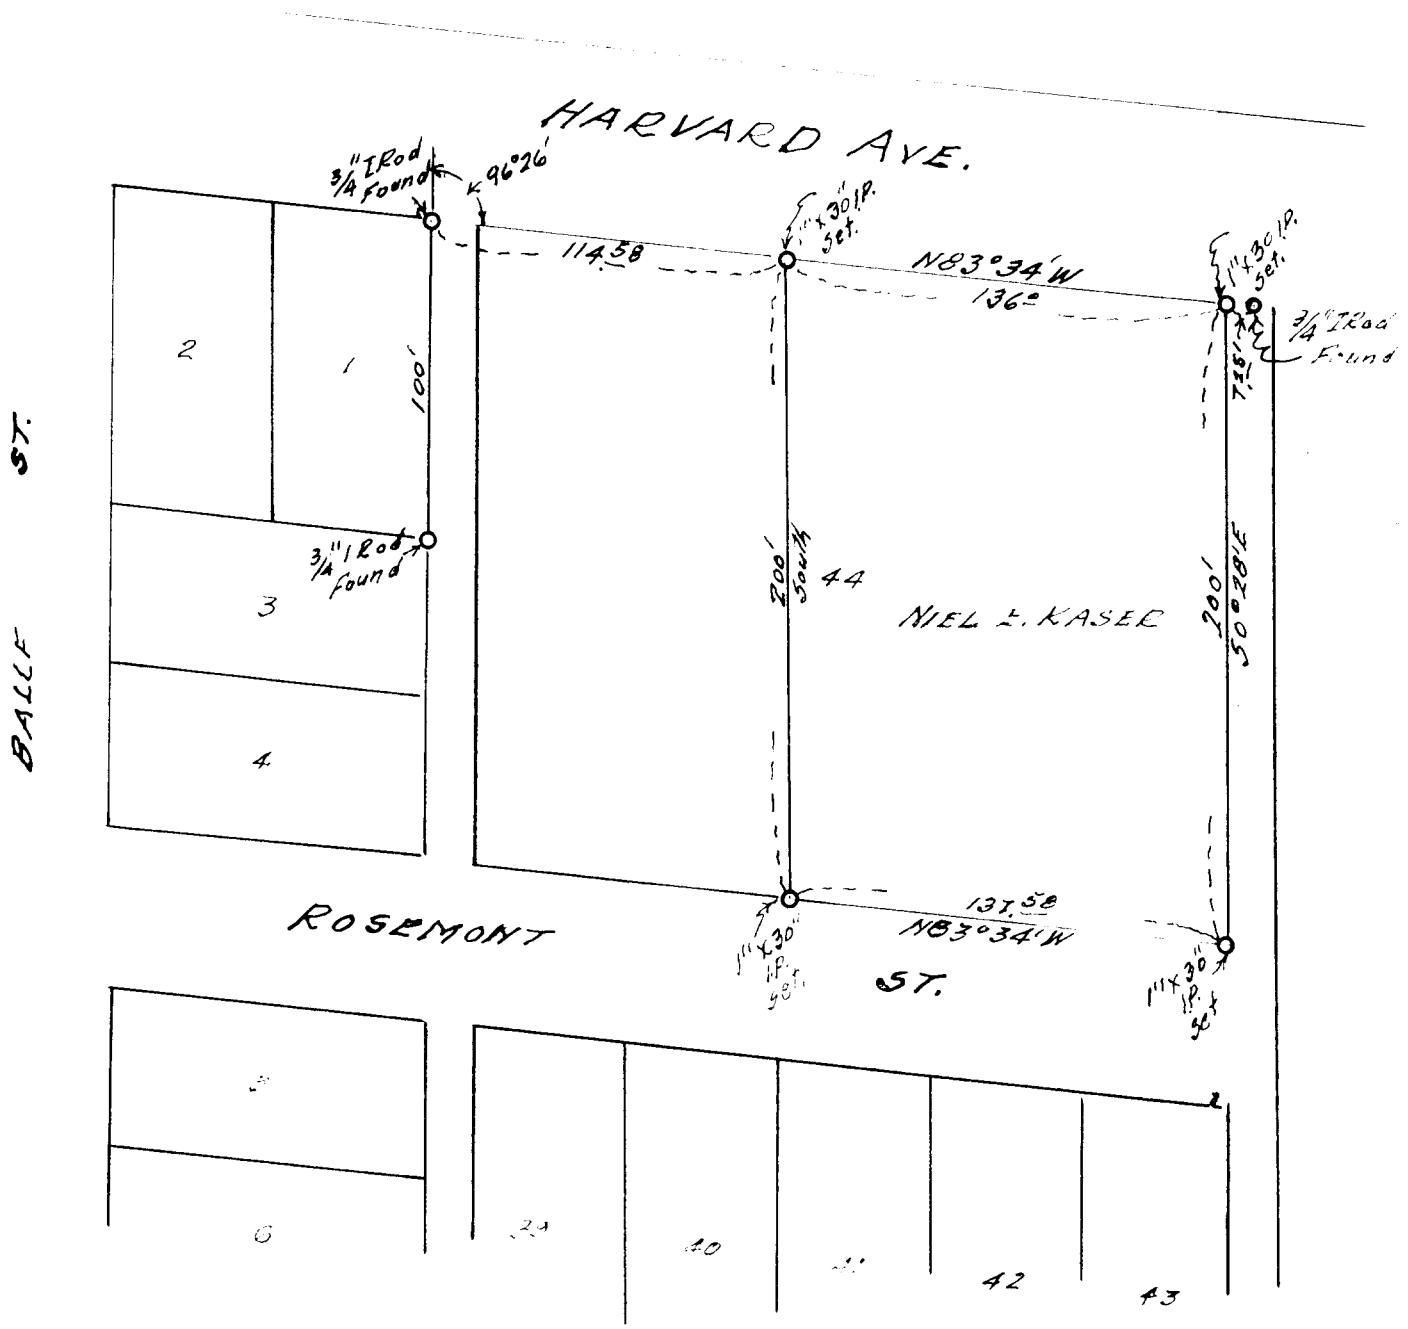

Edwin S Woodford

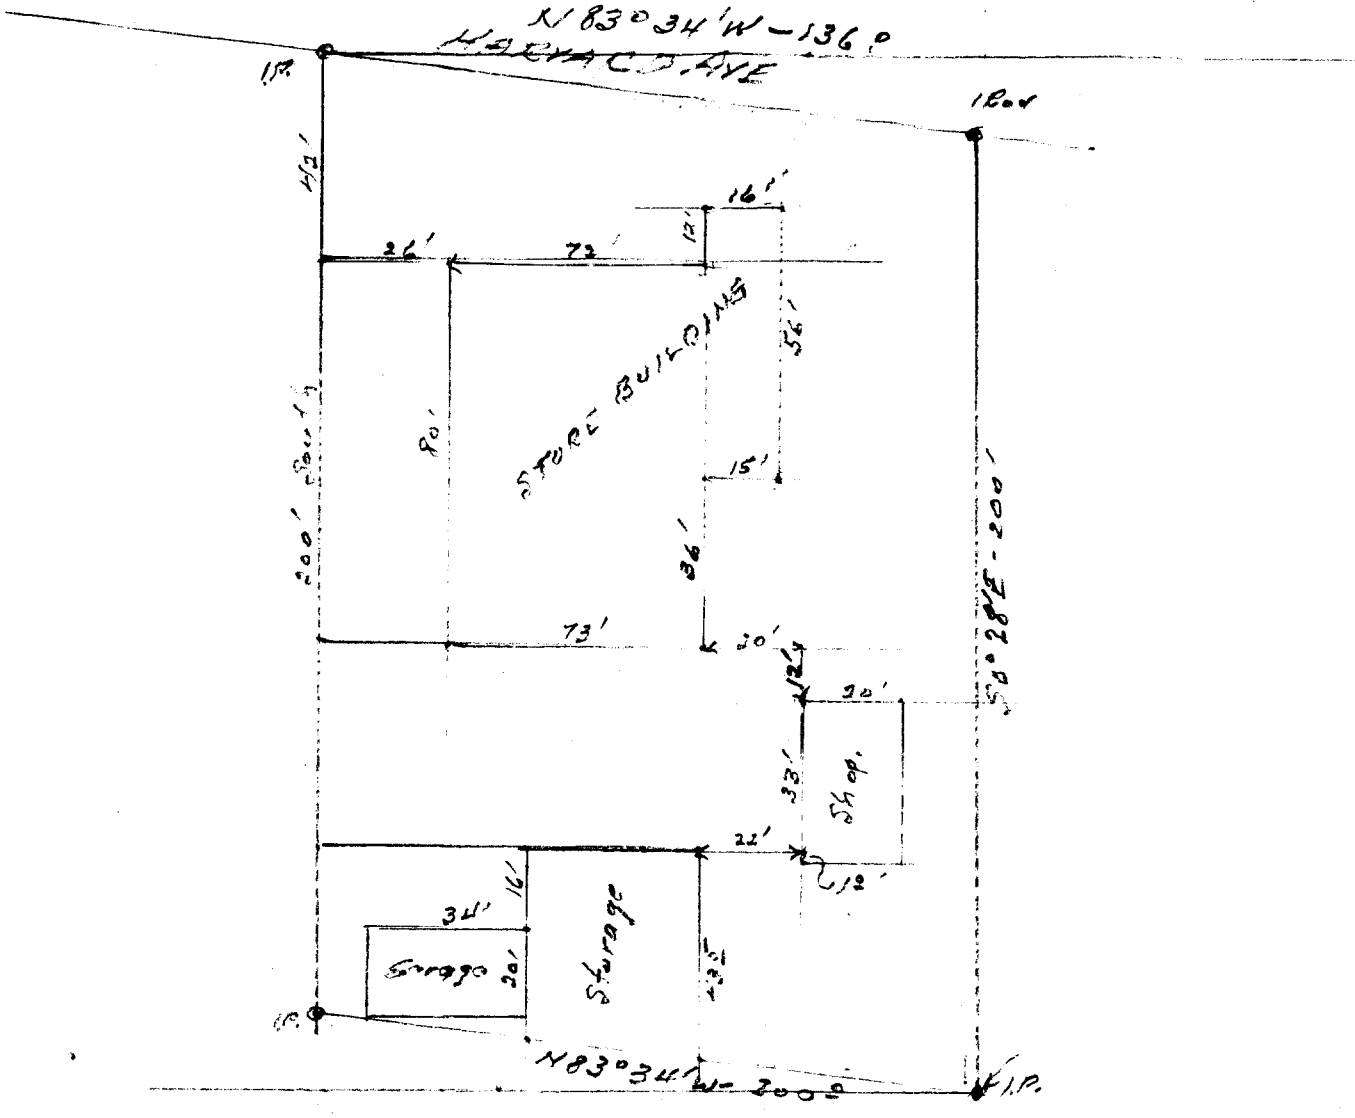

Scale - 1" = 40'

51/28-1b