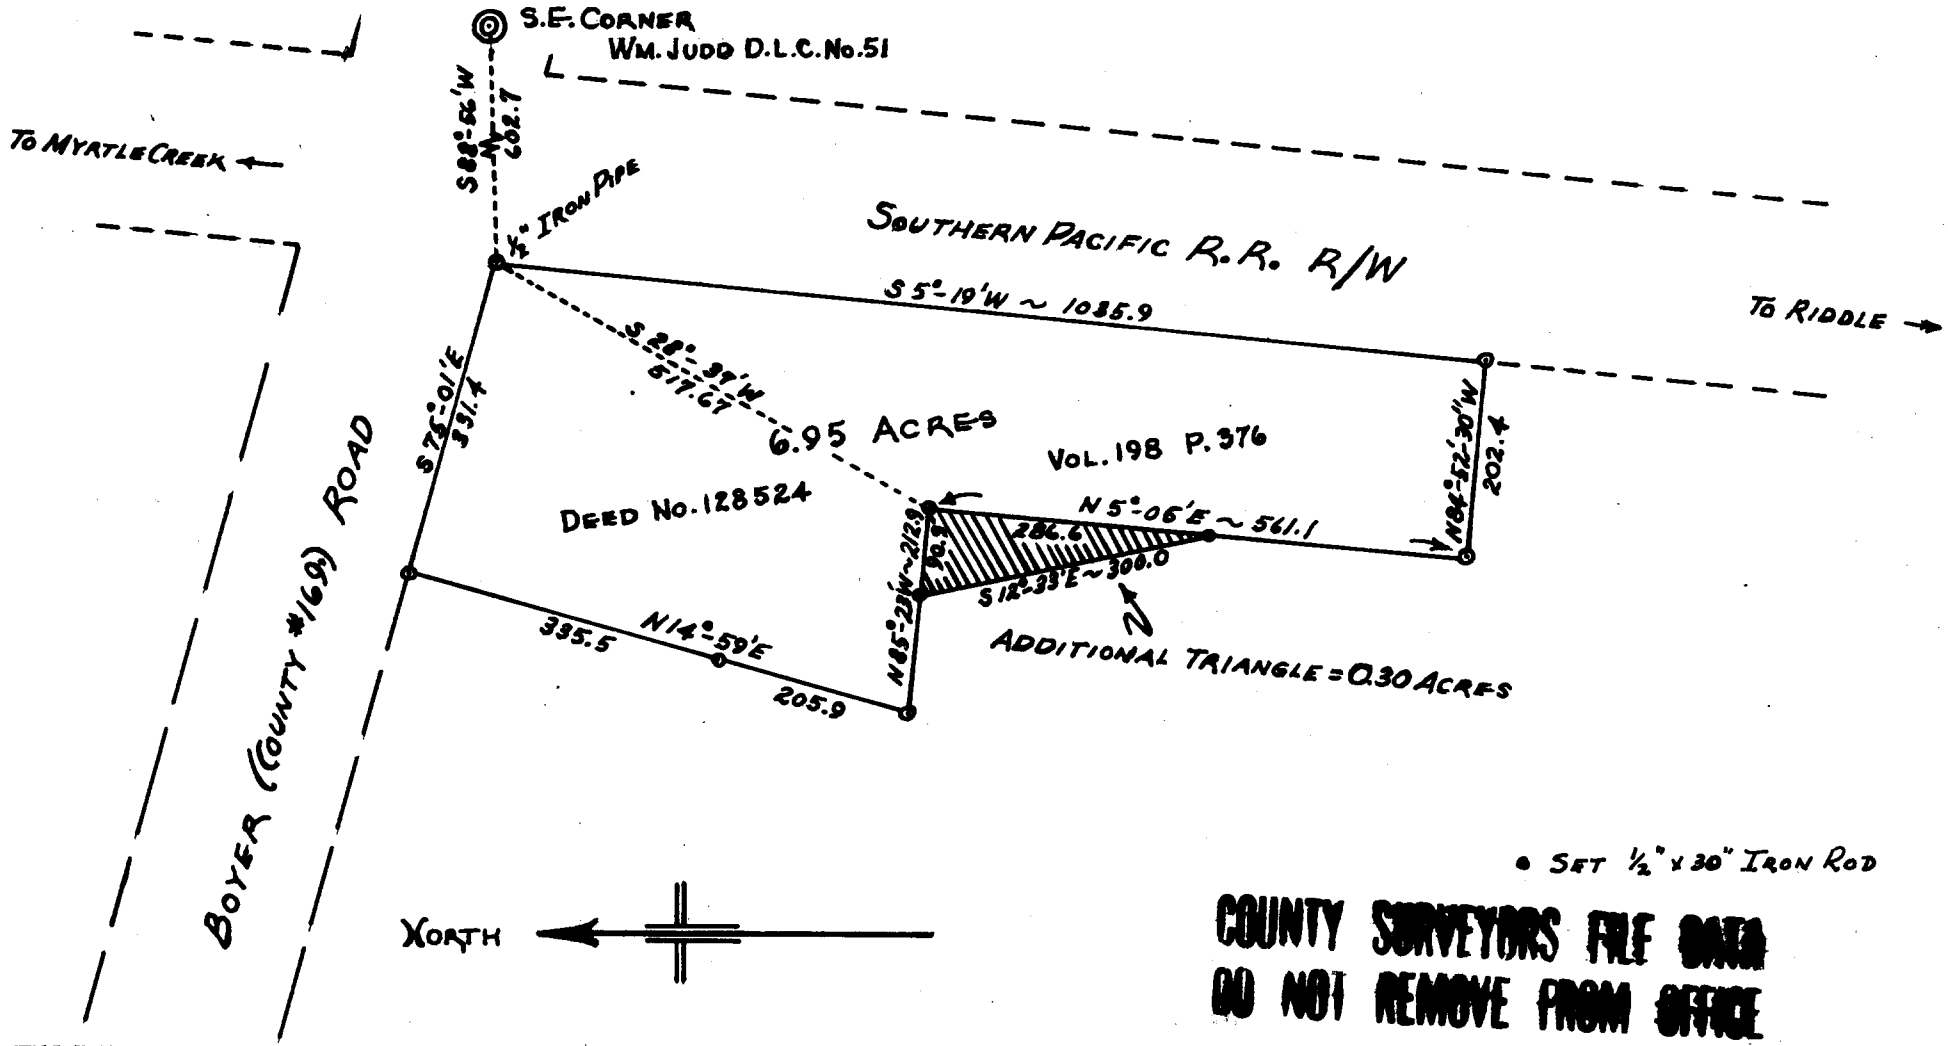


• SET ½" x 30" IRON ROD

COUNTY SURVEYORS FILE DATA
DO NOT REMOVE FROM OFFICE

FILED & RECEIVED
MAR 26 1960
COUNTY SURVEYOR
DOUGLAS COUNTY, ORE.

FEBRUARY 1959

REGISTERED PROFESSIONAL ENGINEER
3900
Donald R. Martin
OREGON
NOV. 4, 1955
DONALD R. MARTIN

PLAT PREPARED FOR

D. R. JOHNSON LUMBER CO.
RIDDLE, OREGON

SEC. 13 T30S R6W W.M. DOUGLAS COUNTY, OREGON

SCALE: 1 IN. = 200 FT.

MARTIN ENGINEERING SERVICE ~ MYRTLE CREEK, ORE.

C. S. File No. 51/80