

RESTORED CORNER FOR NATIONAL PLYWOOD, INC.

The quarter corner common to Sections 8 and 9, Township 25 South, Range 1 West, W.M., Douglass County, Oregon.

The original surveyor misnamed the species of the bearing trees, read the bearings from the trees to the corner instead of from the corner to the trees, and called one of the distances incorrectly. He also called the streams and ridges on the section line from the south at grossly incorrect distances and fouled up the description of the section corner to the south.

ORIGINAL NOTES

A squared post, from which as:

4" Dogwood bears S80°E, 17.2 ft.

5" Cedar bears S76°W, 12.5 ft.

RESTORED

Set a square maple post, from which as:


50" Fir, an original bearing tree with the scribes visible and facing the corner, bears N80°W, 22.5 ft.

8" Maple, an original bearing tree with the scribes visible and facing the corner, bears N76°E, 12.5 ft.

A line bearing due south from the restored corner about 1/2 chain hits a tree, apparently marked on the original survey as a line tree.



*Bruce A. Shaner*

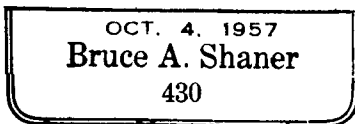

Variation of 20° E

February, 1960

Present & witnessed by:

*William James*

William James

*James B. Griffin*

James B. Griffin

FILED  
RECEIVED

APR 21 1960

COUNTY SURVEYOR  
DOUGLAS COUNTY, ORE.