

RESTORED CORNER FOR NATIONAL PLYWOOD, INC.

The quarter corner common to Sections 8 and 17, Township 25 South, Range 1 West, W. M., Douglas County, Oregon.

The original surveyor misnamed the bearing tree species, as shown following.

ORIGINAL

Basalt stone, 16" x 10" x 6", "1/4" scratched on north face, from which a:
(The above stone may or not be present, as a cedar windfall lays over the spot.)

4" Dogwood bears N16°E, 42 links.

5" Hemlock bears S35°W, 12 links.

RESTORED


Placed a mark on a cedar windfall (which possibly lays over the original stone), from which a:

11" Hemlock, broken off, with scribes visible, bears N 16° E, 42 links.

8" Yew with scribes visible bears S35°W, 12 links.



Bruce A. Shaner

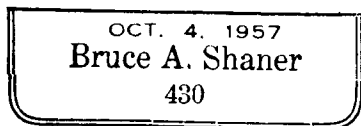

Variation of 20° E

February 1, 1960

Present & witnessed by:

William James
William James

James B. Griffin
James B. Griffin

FILED
RECEIVED

APR 21 1960

COUNTY SURVEYOR
DOUGLAS COUNTY, ORE.