

RESTORED CORNER FOR NATIONAL PLYWOOD, INC.

The quarter corner common to Sections 4 and 5, Township 30 South, Range 2 West, W. M., Douglas County, Oregon.

ORIGINAL

A slate stone, 18" x 10" x 10", 12" in the ground, marked "1/4" on the west face. (This stone is missing; two windfalls have recently slid over the area.)

From this stone, as:

Fir, 15" diameter, bears N75°E, 21 links distant, marked "1/4 S 4 BT". (A rotten Douglas fir stump, with scribes visible, was found here.)

Fir, 18" diameter, bears S11 1/2°W, 7 links distant, marked "1/4 S 5 BT". (A 10" diameter Hemlock, dead and down, marked "1/4 S 5 BT", was found here.)

RESTORED

I set a 3/4" Iron Pipe for the 1/4 corner, from which as:

Pair of original BT's, as described above, fit the correct description.

40" Douglas Fir, scribed "1/4 S BT", bears N69°E, 8.8 feet.

5" Yew, scribed "1/4 S BT", bears S46°30'W, 12.5 feet.

Variation of 20°E

June 21, 1960


Present & Witnessed By:

William James
William James

James B. Griffin
James B. Griffin



Bruce A. Shaner

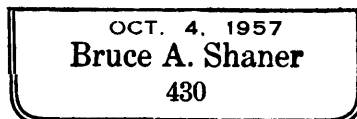

FILED *L.d.*
RECEIVED

JUL 22 1960

COUNTY SURVEYOR
DOUGLAS COUNTY, ORE.

✓ C. S. File No. 51/105-1