

RESTORED CORNER FOR NATIONAL PLYWOOD, INC.

The quarter corner common to Sections 14 & 15, Township 30 South, Range 3 West, W. M., Douglas County, Oregon.

ORIGINAL

A stone, now missing, 13" x 12" x 5", 9 inches in a mound of stone, with "1/4" on the W face, from which a:

Hemlock, 3 1/4" diameter, now dead and down but with the scribes "1/4 S" visible on it, bears N37°W, 52 1/2 links.

Alder, 15" diameter, now missing, bears S30 1/4°E, 10 1/2 links.

RESTORED

Set a brass rod, 5/8" x 27", in the proper position for the 1/4 corner, and from which a:


Yew, 12" diameter, newly scribed "1/4 S BT", bears N28 1/2°W, 27.5 feet.

Hemlock, 8" diameter, newly scribed "1/4 S BT", bears N50°E, 4.0 feet.

Douglas fir, 72" diameter, a line tree as described by the Surveyor General, bore South 1.65 chains (108.9 feet). This tree was logged a year or so ago and only the stump remains, but Wm. James and J.B. Griffin identified the line tree and the corner, prior to the line tree's being cut.



*Bruce A. Shaner*

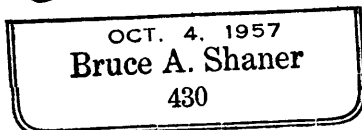

Date: August 16, 1960  
Declination of 20° E

Present & witnessed by:

*William James*  
William James

*James B. Griffin*  
James B. Griffin