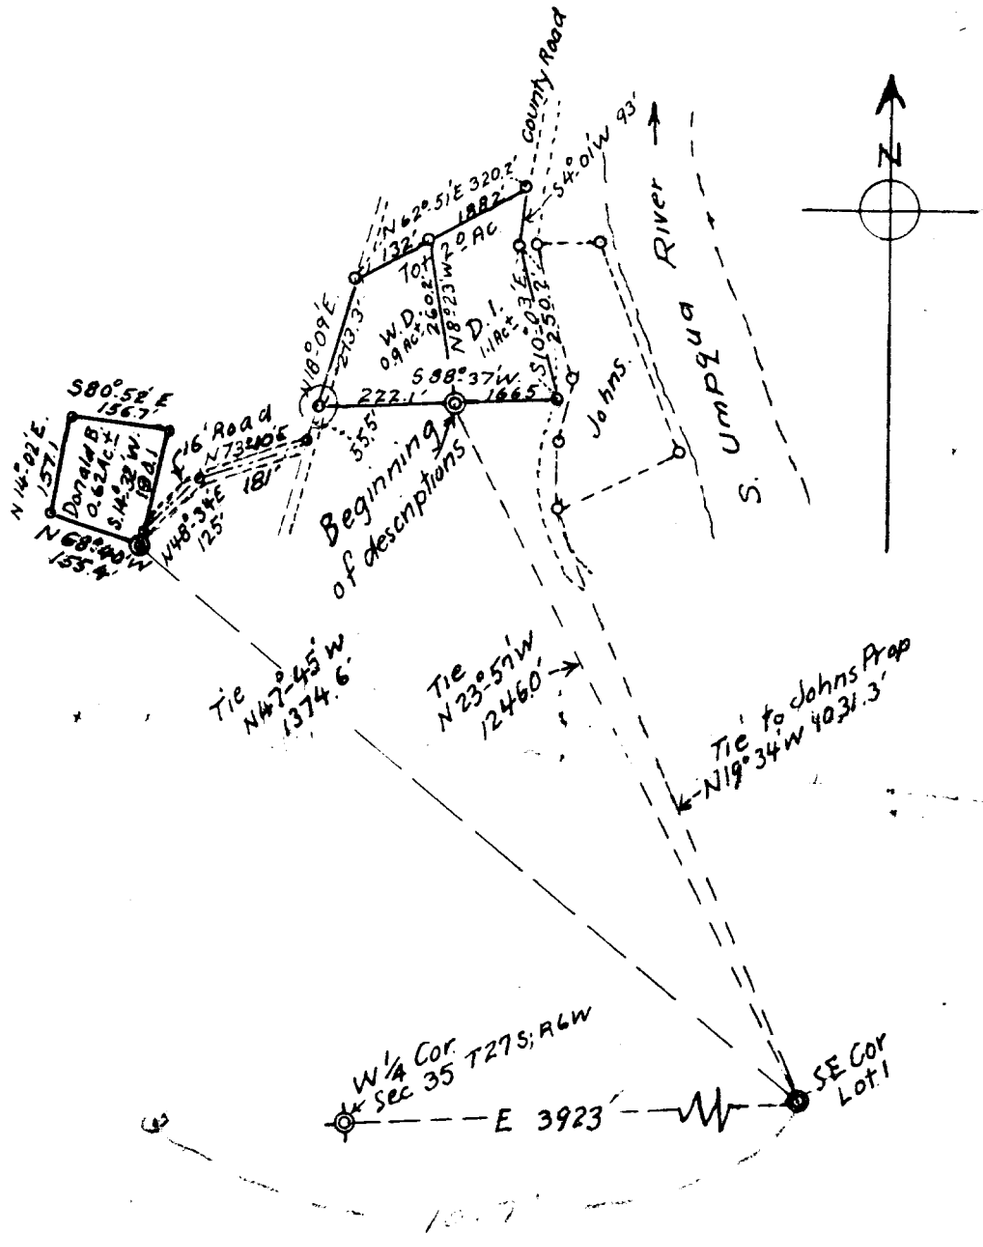

COUNTY SURVEYORS FILE DATA
DO NOT REMOVE FROM OFFICE

FILED
RECEIVED
JUL 2 3 1980
COUNTY SURVEYOR
DOUGLAS COUNTY, ORE.

W. H. McLAIN et ux
Portion of
Lot 1, Block A
Umpqua Park in
Sec. 35, T27S; R6W; W.M.
Feb. 1949 R.B. 1"=300'

C. S. File No. 31/101