BOB SULLIVAN PARCELS - WINCHESTER - DOUGLAS COUNTY - OREGON

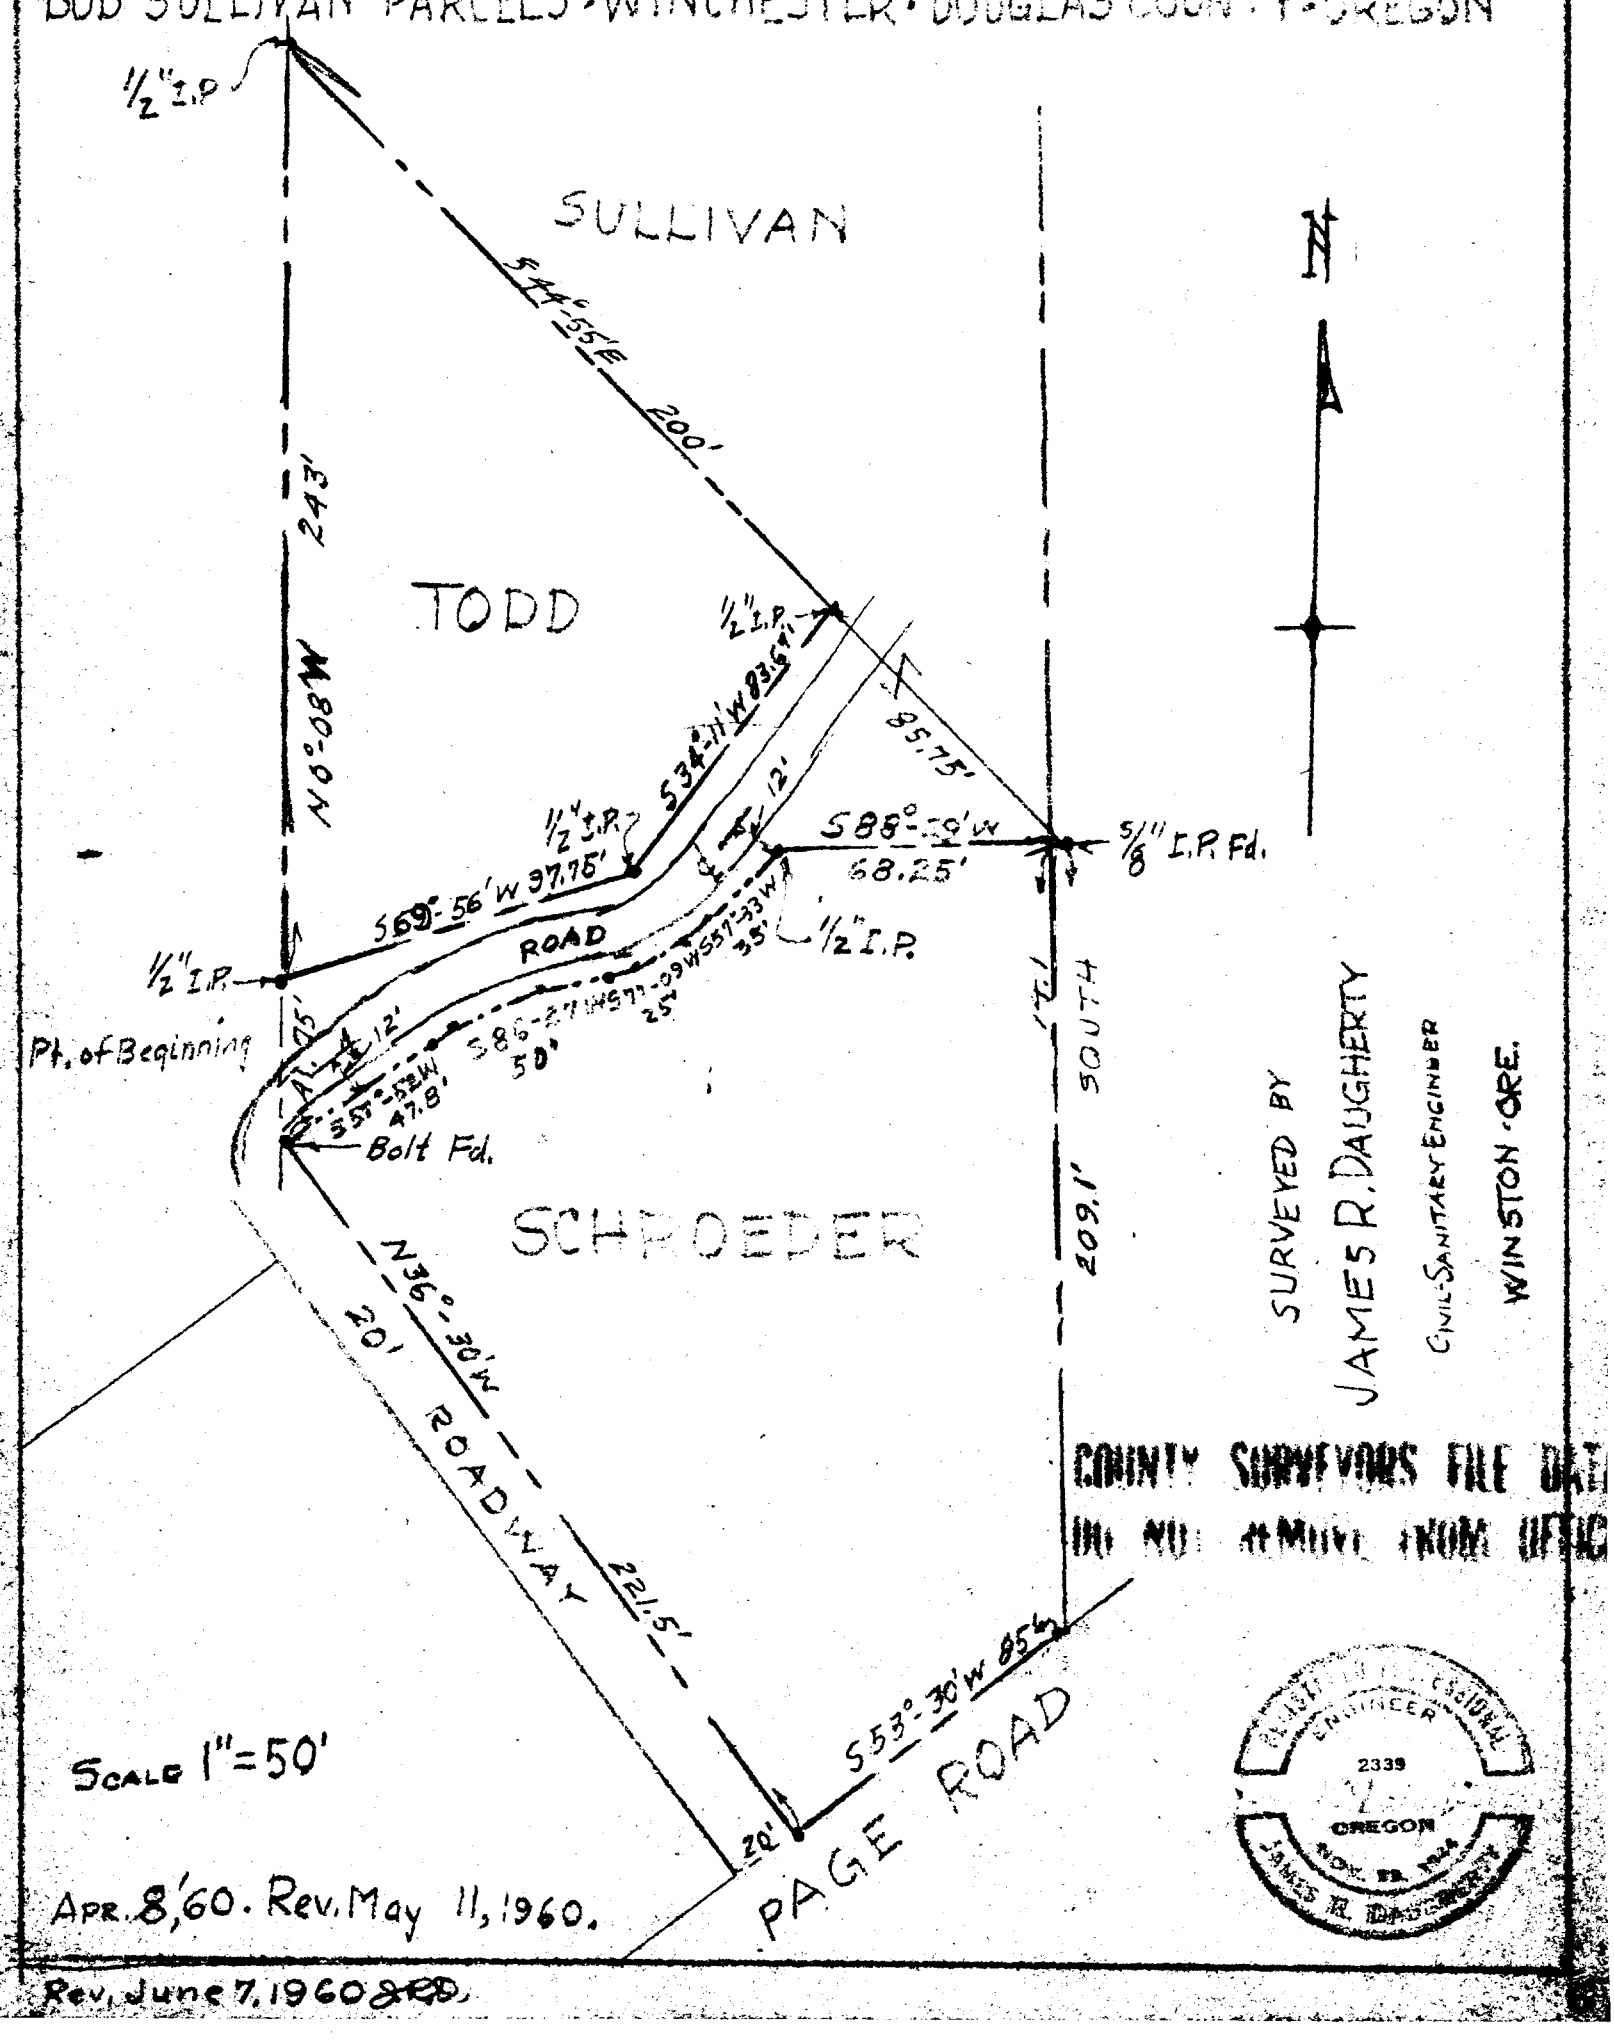

SCALE 1" = 50'

APR. 8, '60. REV. MAY 11, 1960.

REV. JUNE 7, 1960