CHESTER L. JENNINGS PARCELS · SECT. 21 · T28S · R8W · W.M.

WINSTON · DOUGLAS COUNTY · OREGON

FILED L. L.
RECEIVED
OCT 23 1961
COUNTY SURVEYOR
DOUGLAS COUNTY, ORE.

COUNTY SURVEYORS FILE
DO NOT REMOVE FROM OFF

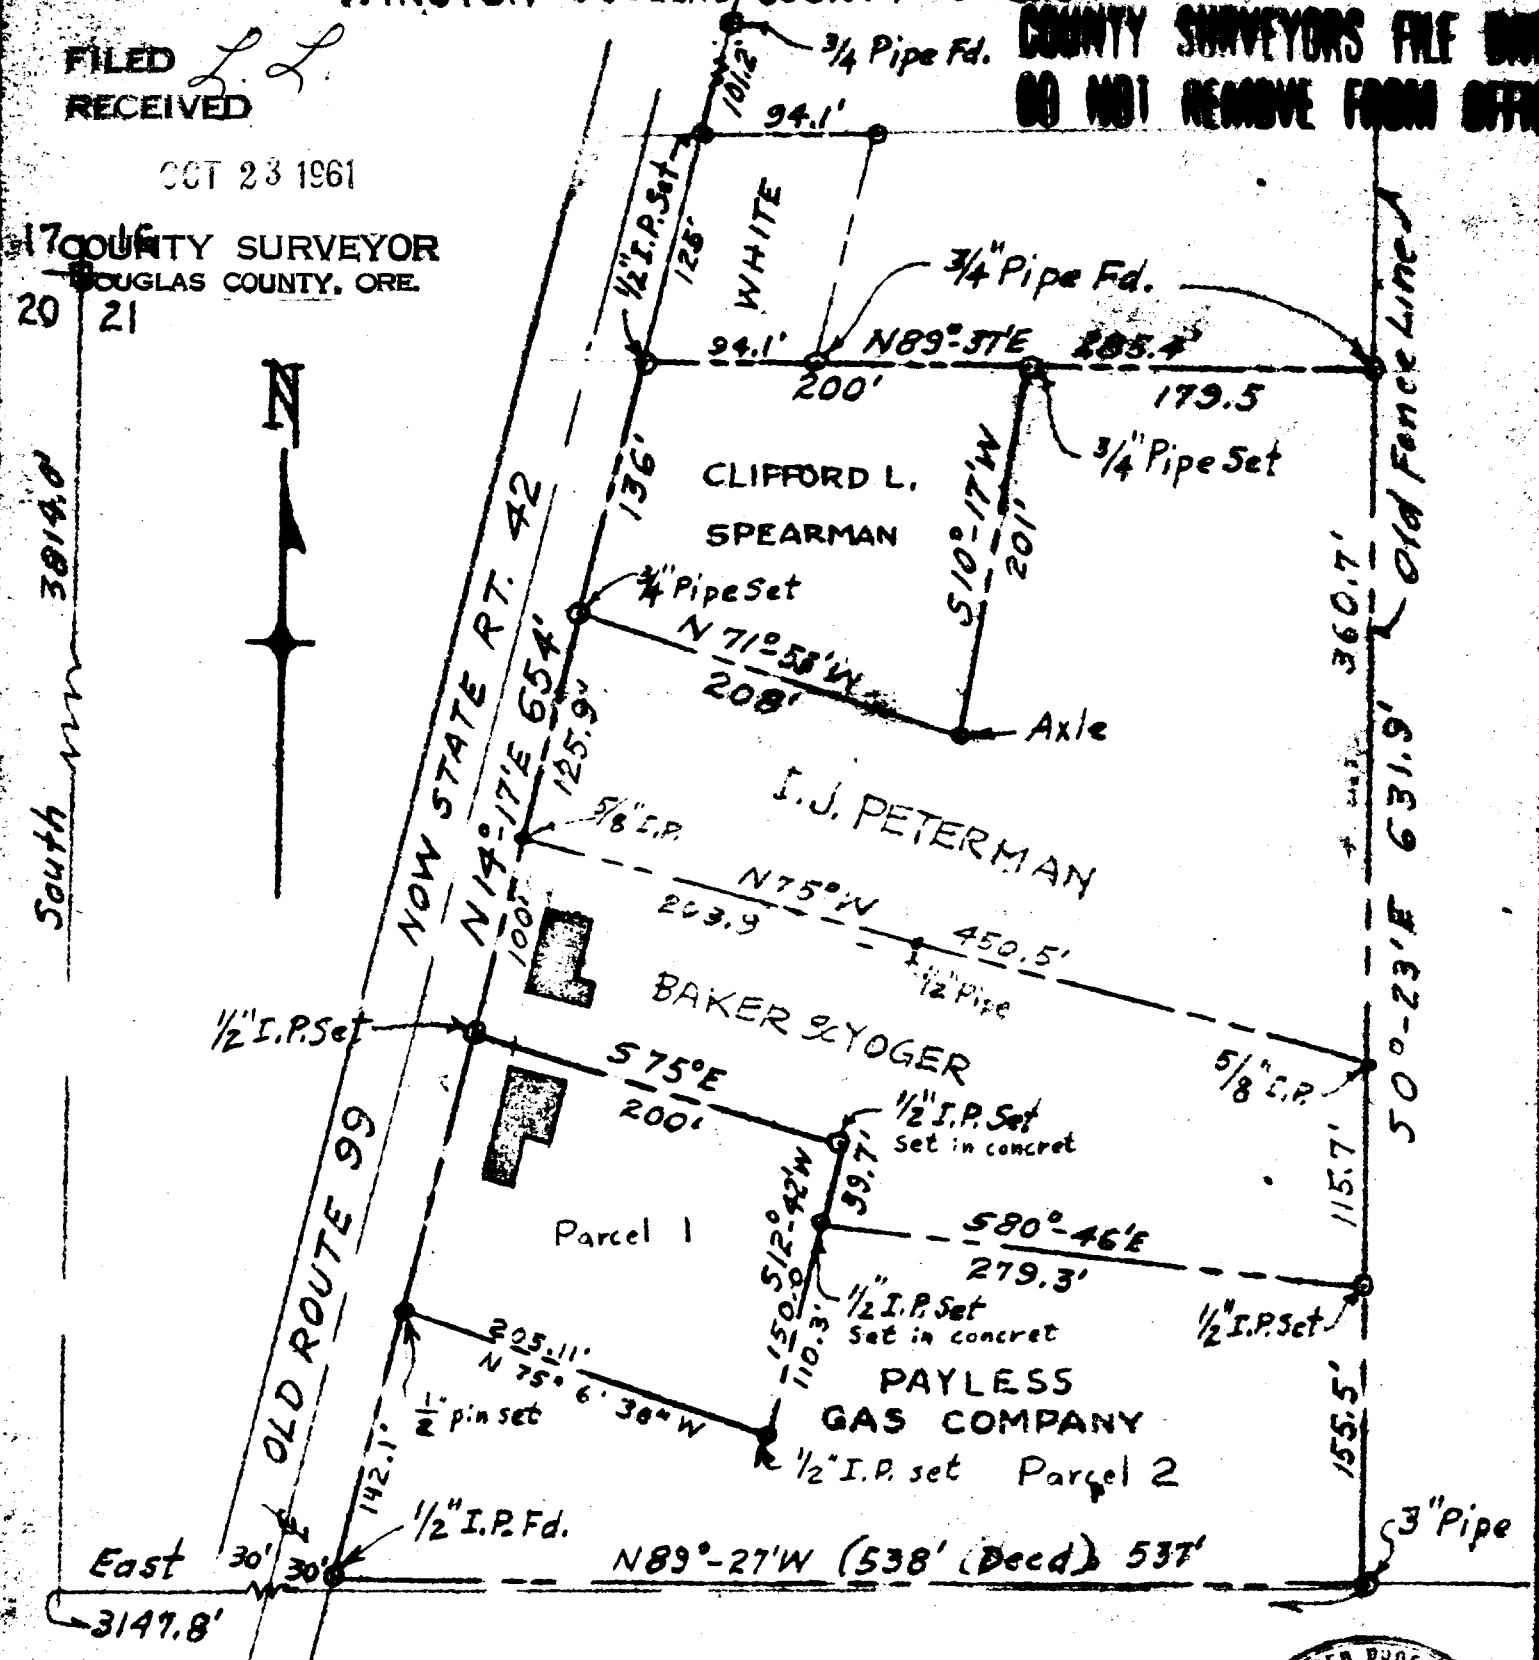

SURVEYED BY

JAMES R. DAUGHERTY

CIVIL-SANITARY ENGINEER

WINSTON · ORE.

SCALE 1" = 100'

Rev. Oct. 10, 1961

JULY 30, 1988 · Rev. June 7, 1960

REGISTERED PROFESSIONAL ENGINEER 2252 James R. Daugherty OREGON NOV. 10, 1944 JAMES R. DAUGHERTY

C. S. File No. 31113-4