


Prepared for

R. J. HART

Scale 1" = 400' Oct. 1951

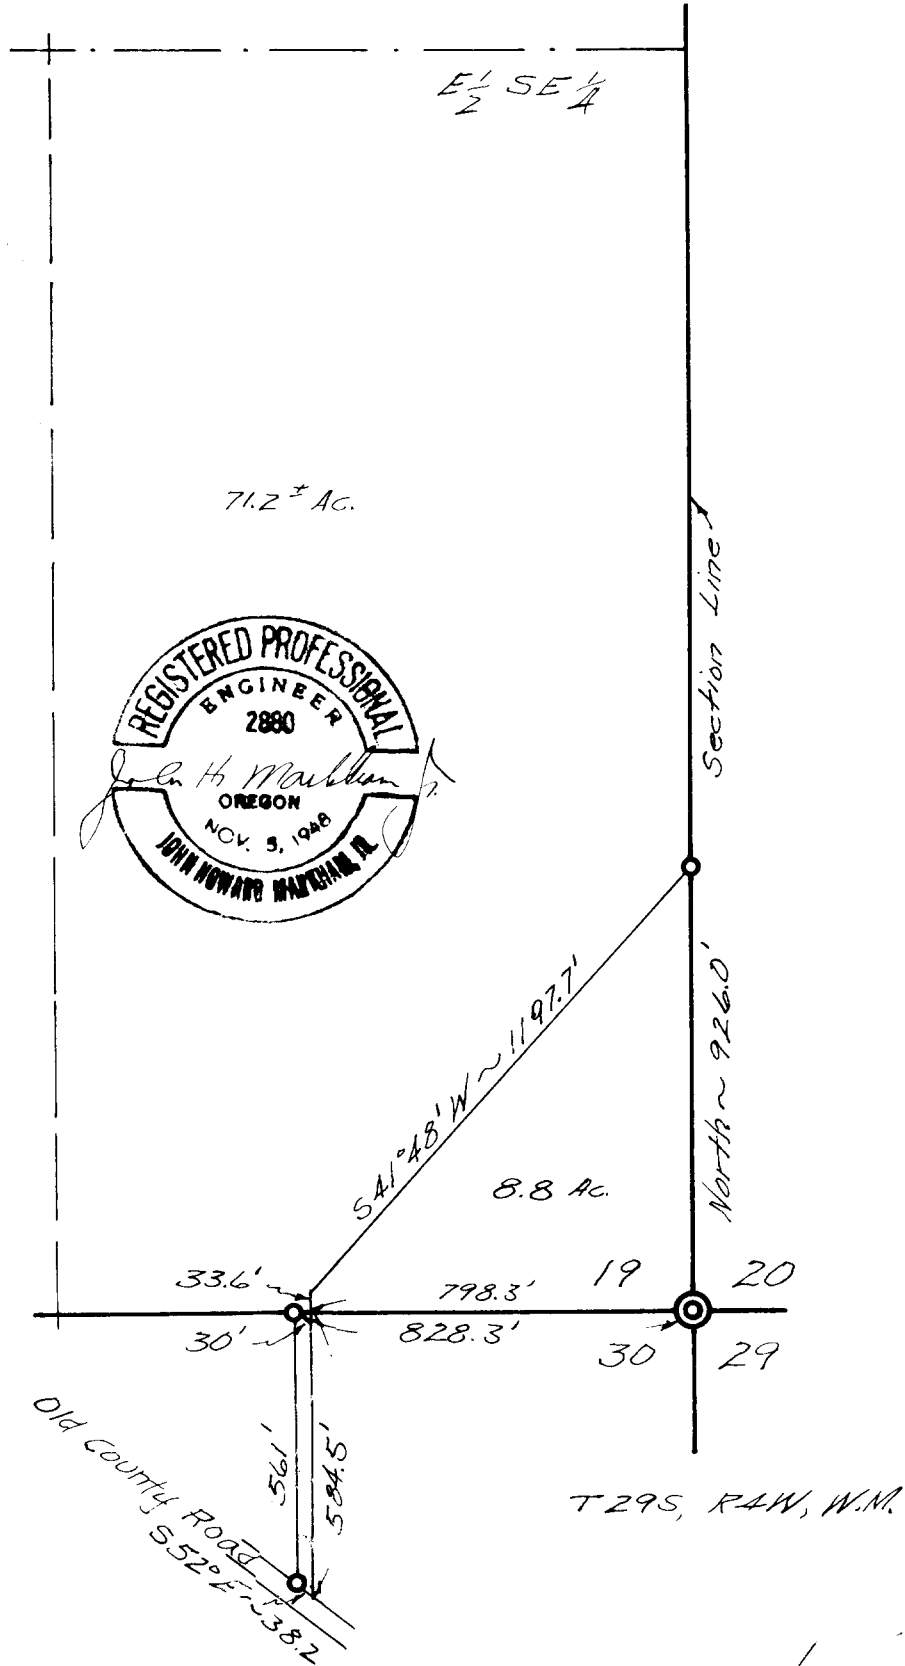

51/129-1 P