COUNTY SURVEYORS FILE DATA
DO NOT REMOVE FROM OFFICE

Prepared for HATFIELD & MASSA

Portion of Sec. 33, T29S, R5W, W.M.

Scale 1" = 200' April 1952.

North

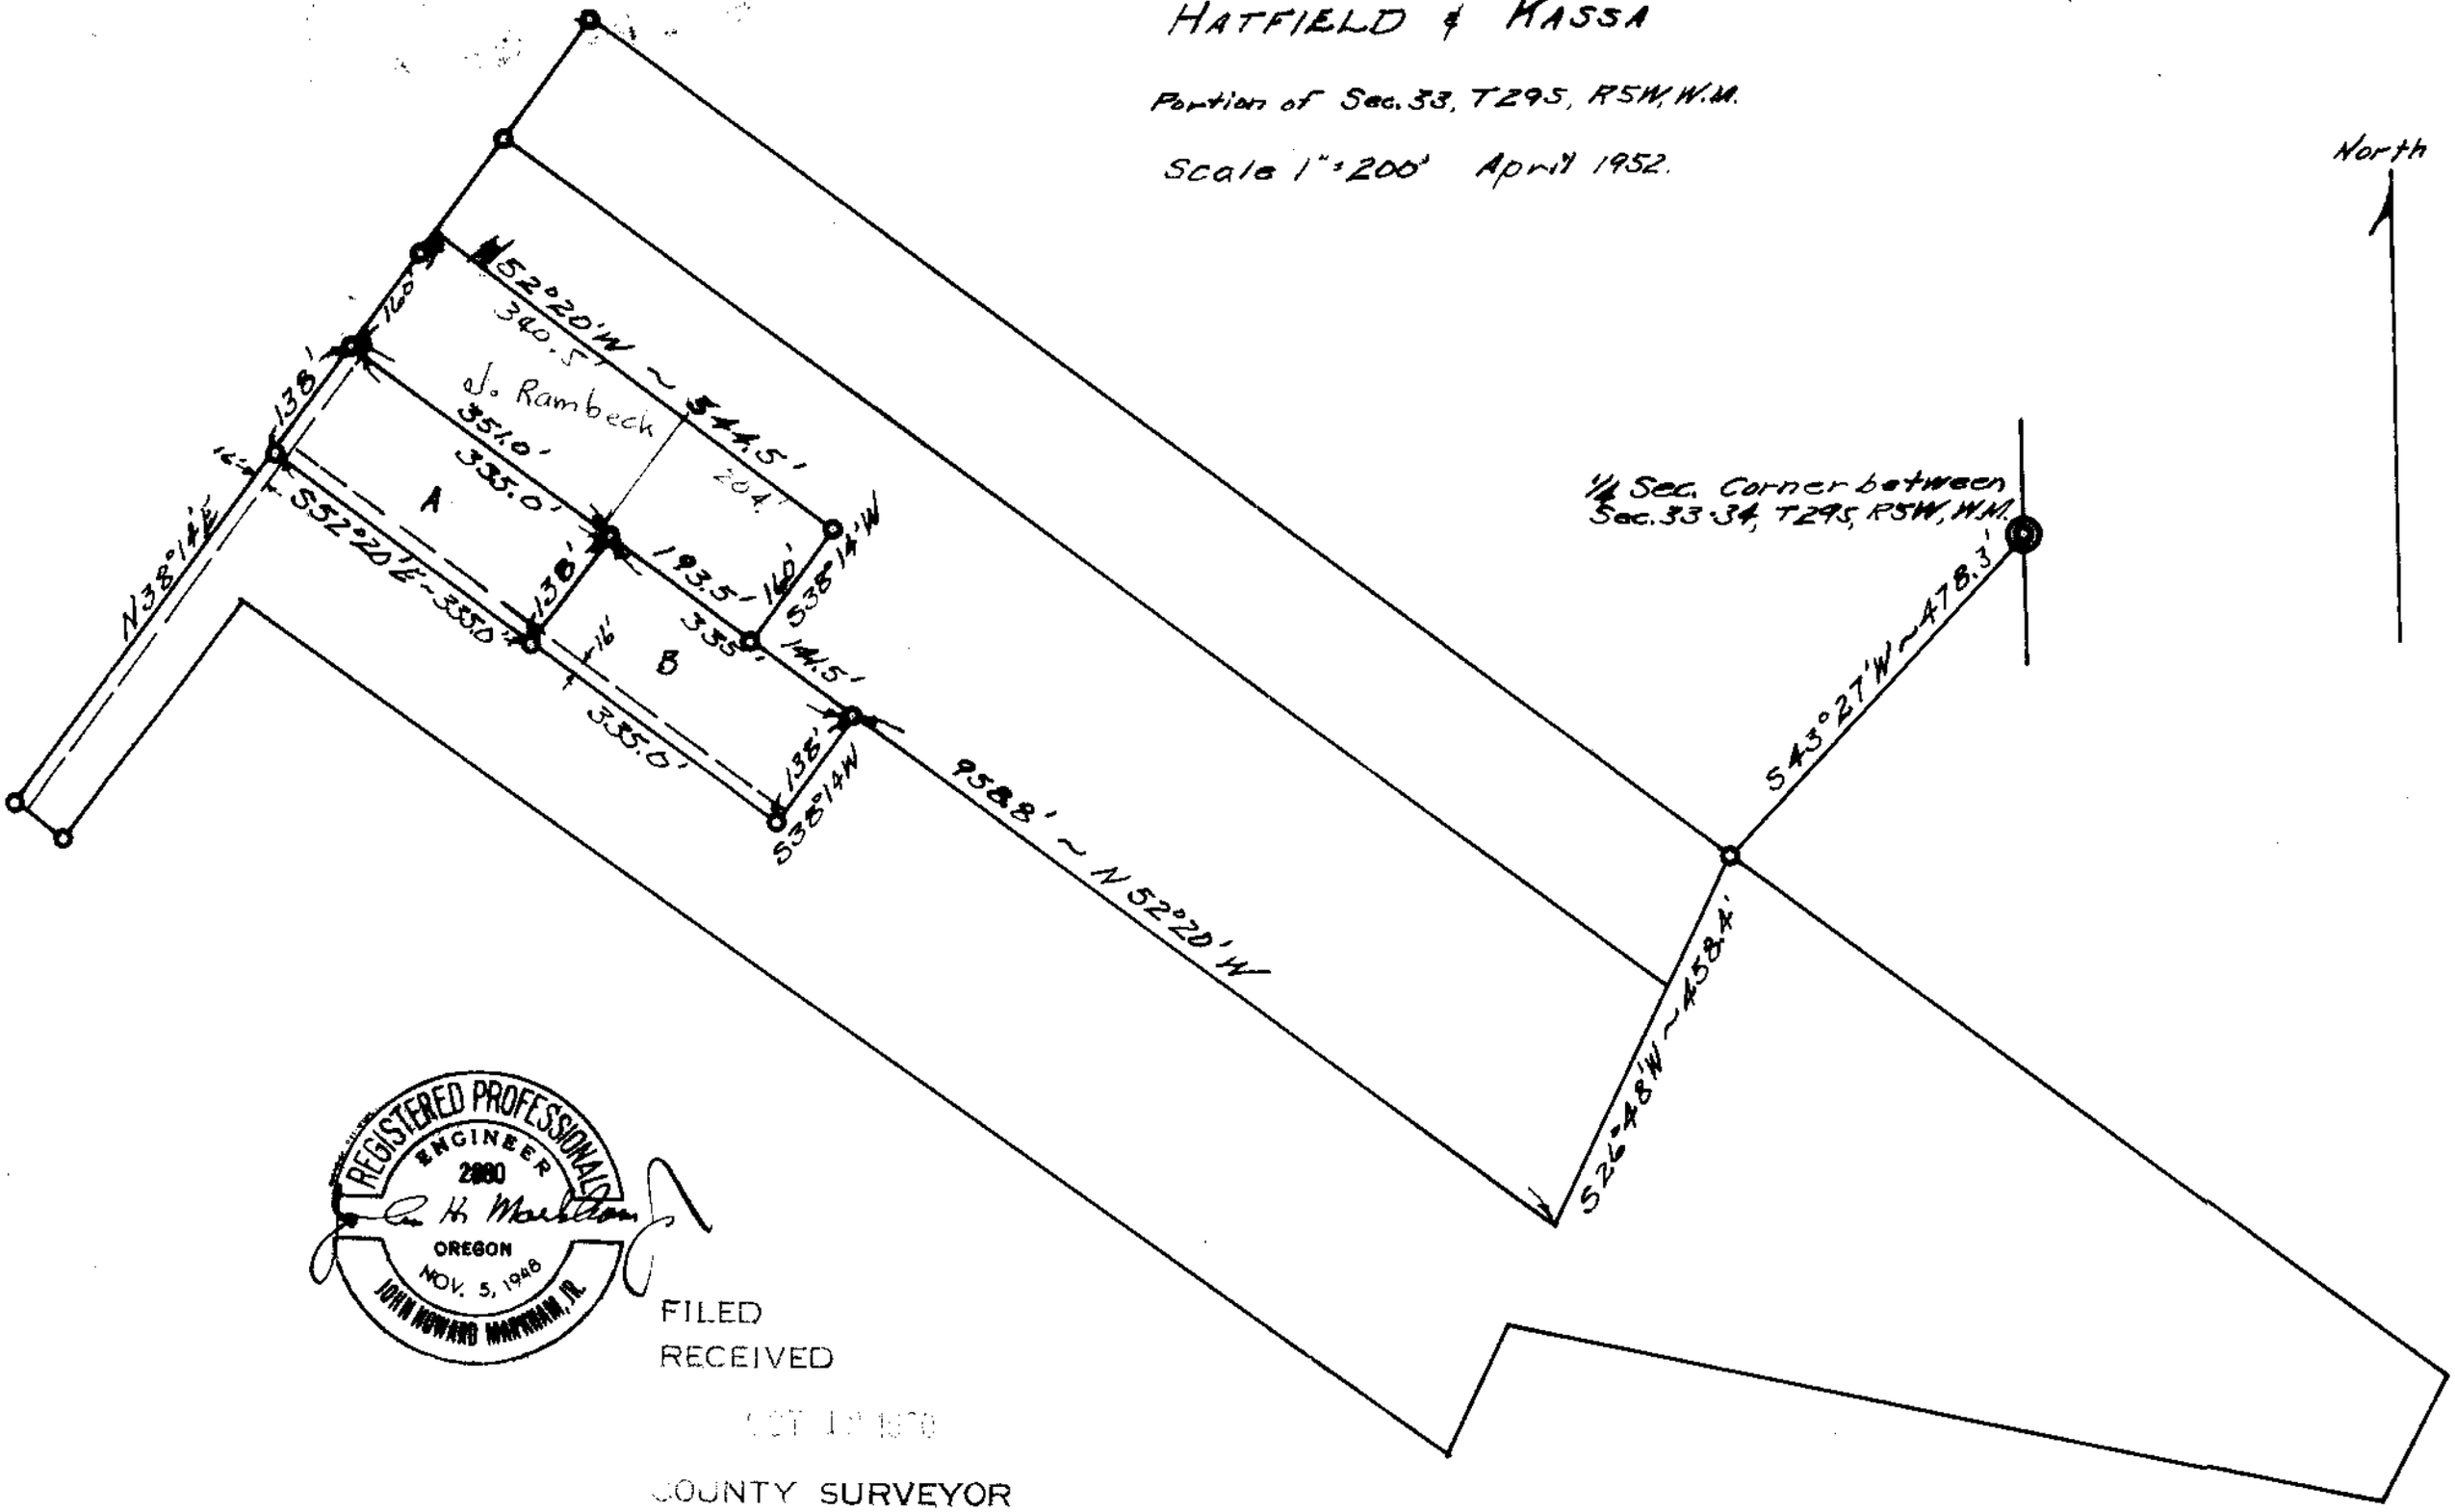

REGISTERED PROFESSIONAL ENGINEER
2880
OREGON
NOV. 5, 1948
JOHN HOWARD MARTHAM, JR.

FILED
RECEIVED
OCT 10 1952
COUNTY SURVEYOR
DOUGLAS COUNTY, ORE.

C. S. File No. 51/130