COUNTY SURVEYORS FILE DATA
DO NOT REMOVE FROM OFFICE

PREPARED FOR

A. J. BOYD

FILED
RECEIVED
COUNTY SURVEYOR
DOUGLAS COUNTY, ORE.

PORTION OF SEC. 30 & 31 T30S R5W

SCALE 1" = 100' MAY 1949

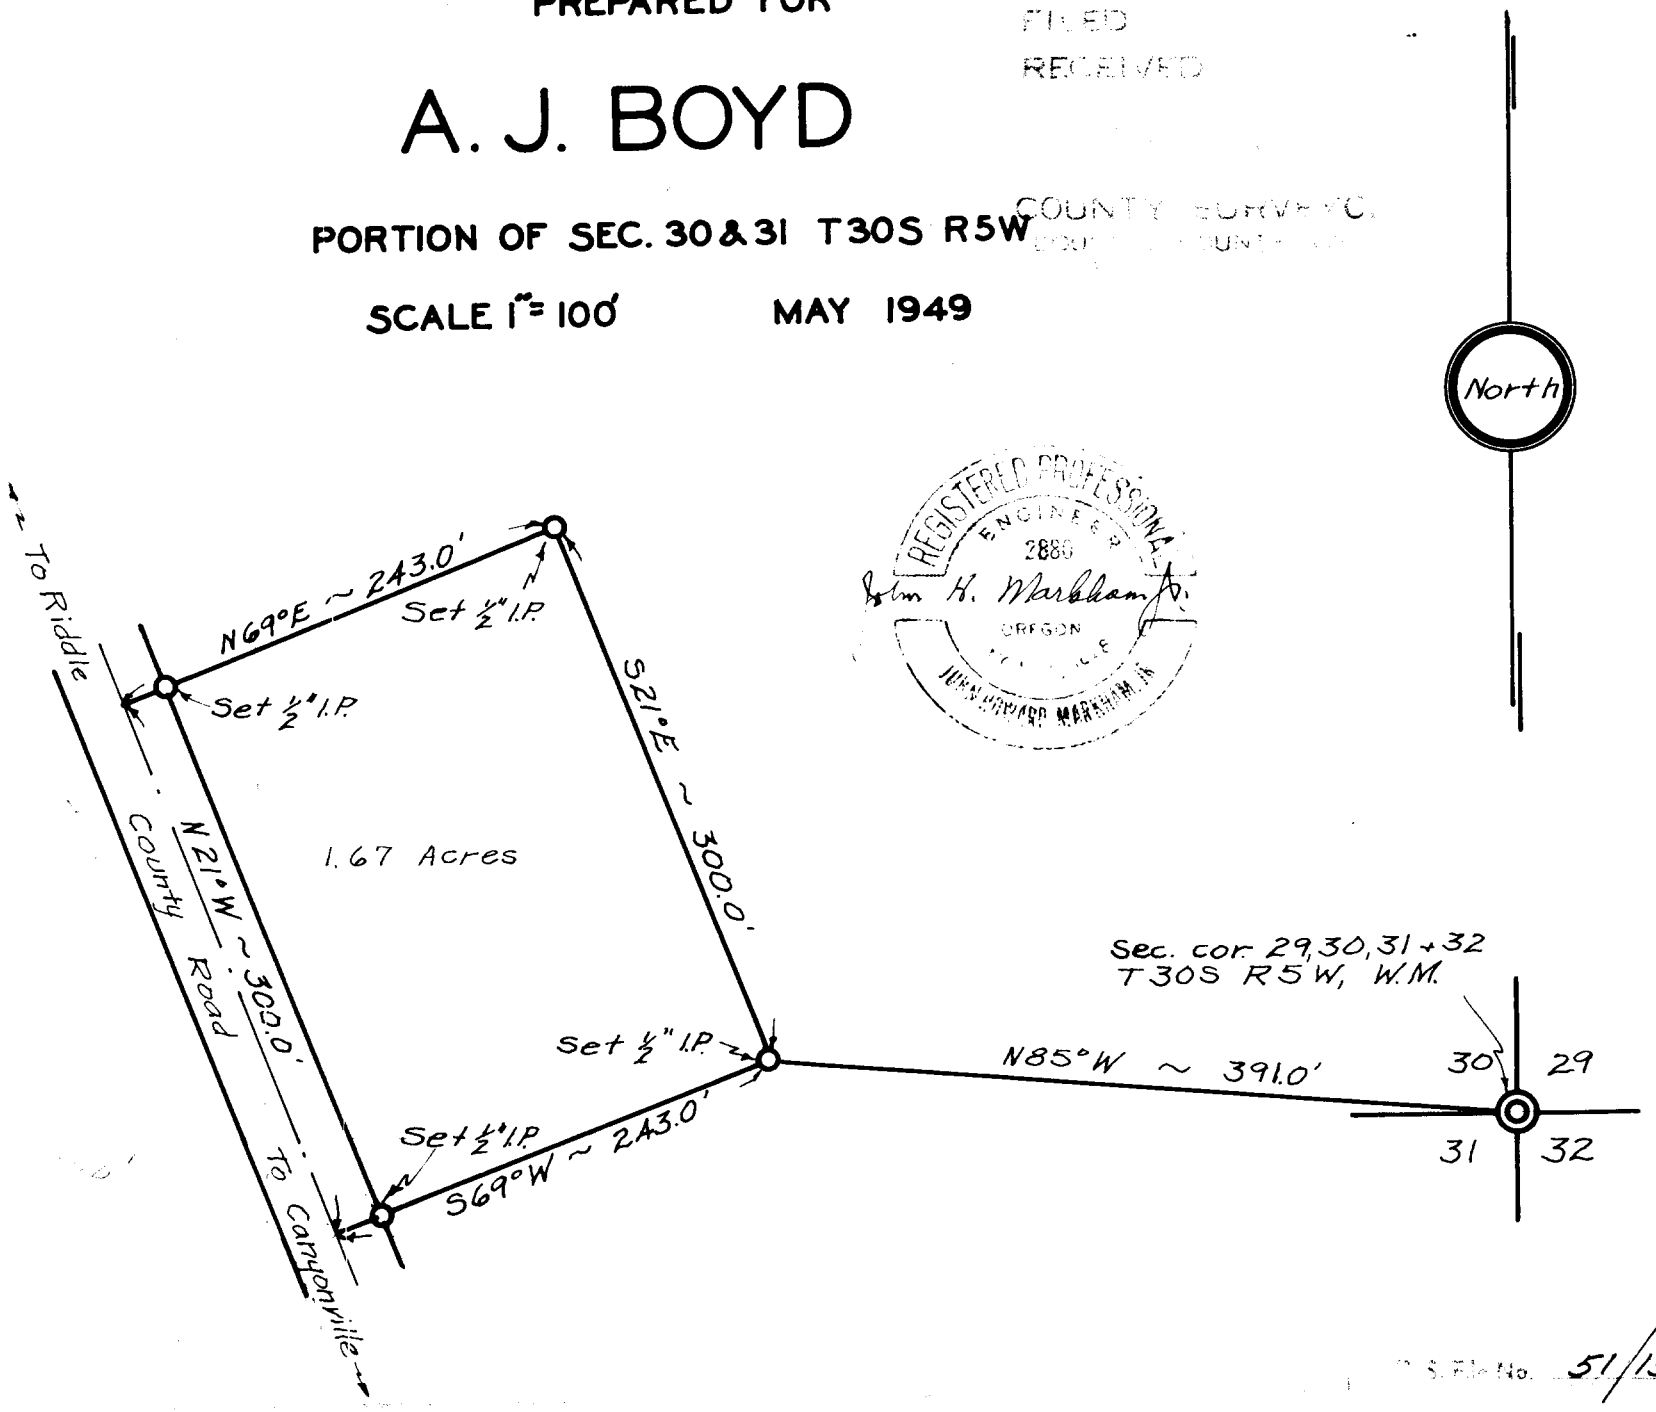

REGISTERED PROFESSIONAL ENGINEER
2886
John H. Markham Jr.
OREGON
JOHN HOWARD MARKHAM JR.

C. S. File No. 51/134-2