10

10

Prepared for

~ Harry Dayton ~

Scale 1" = 100' April 1954

COUNTY SURVEYORS FILE DATA
DO NOT REMOVE FROM OFFICE

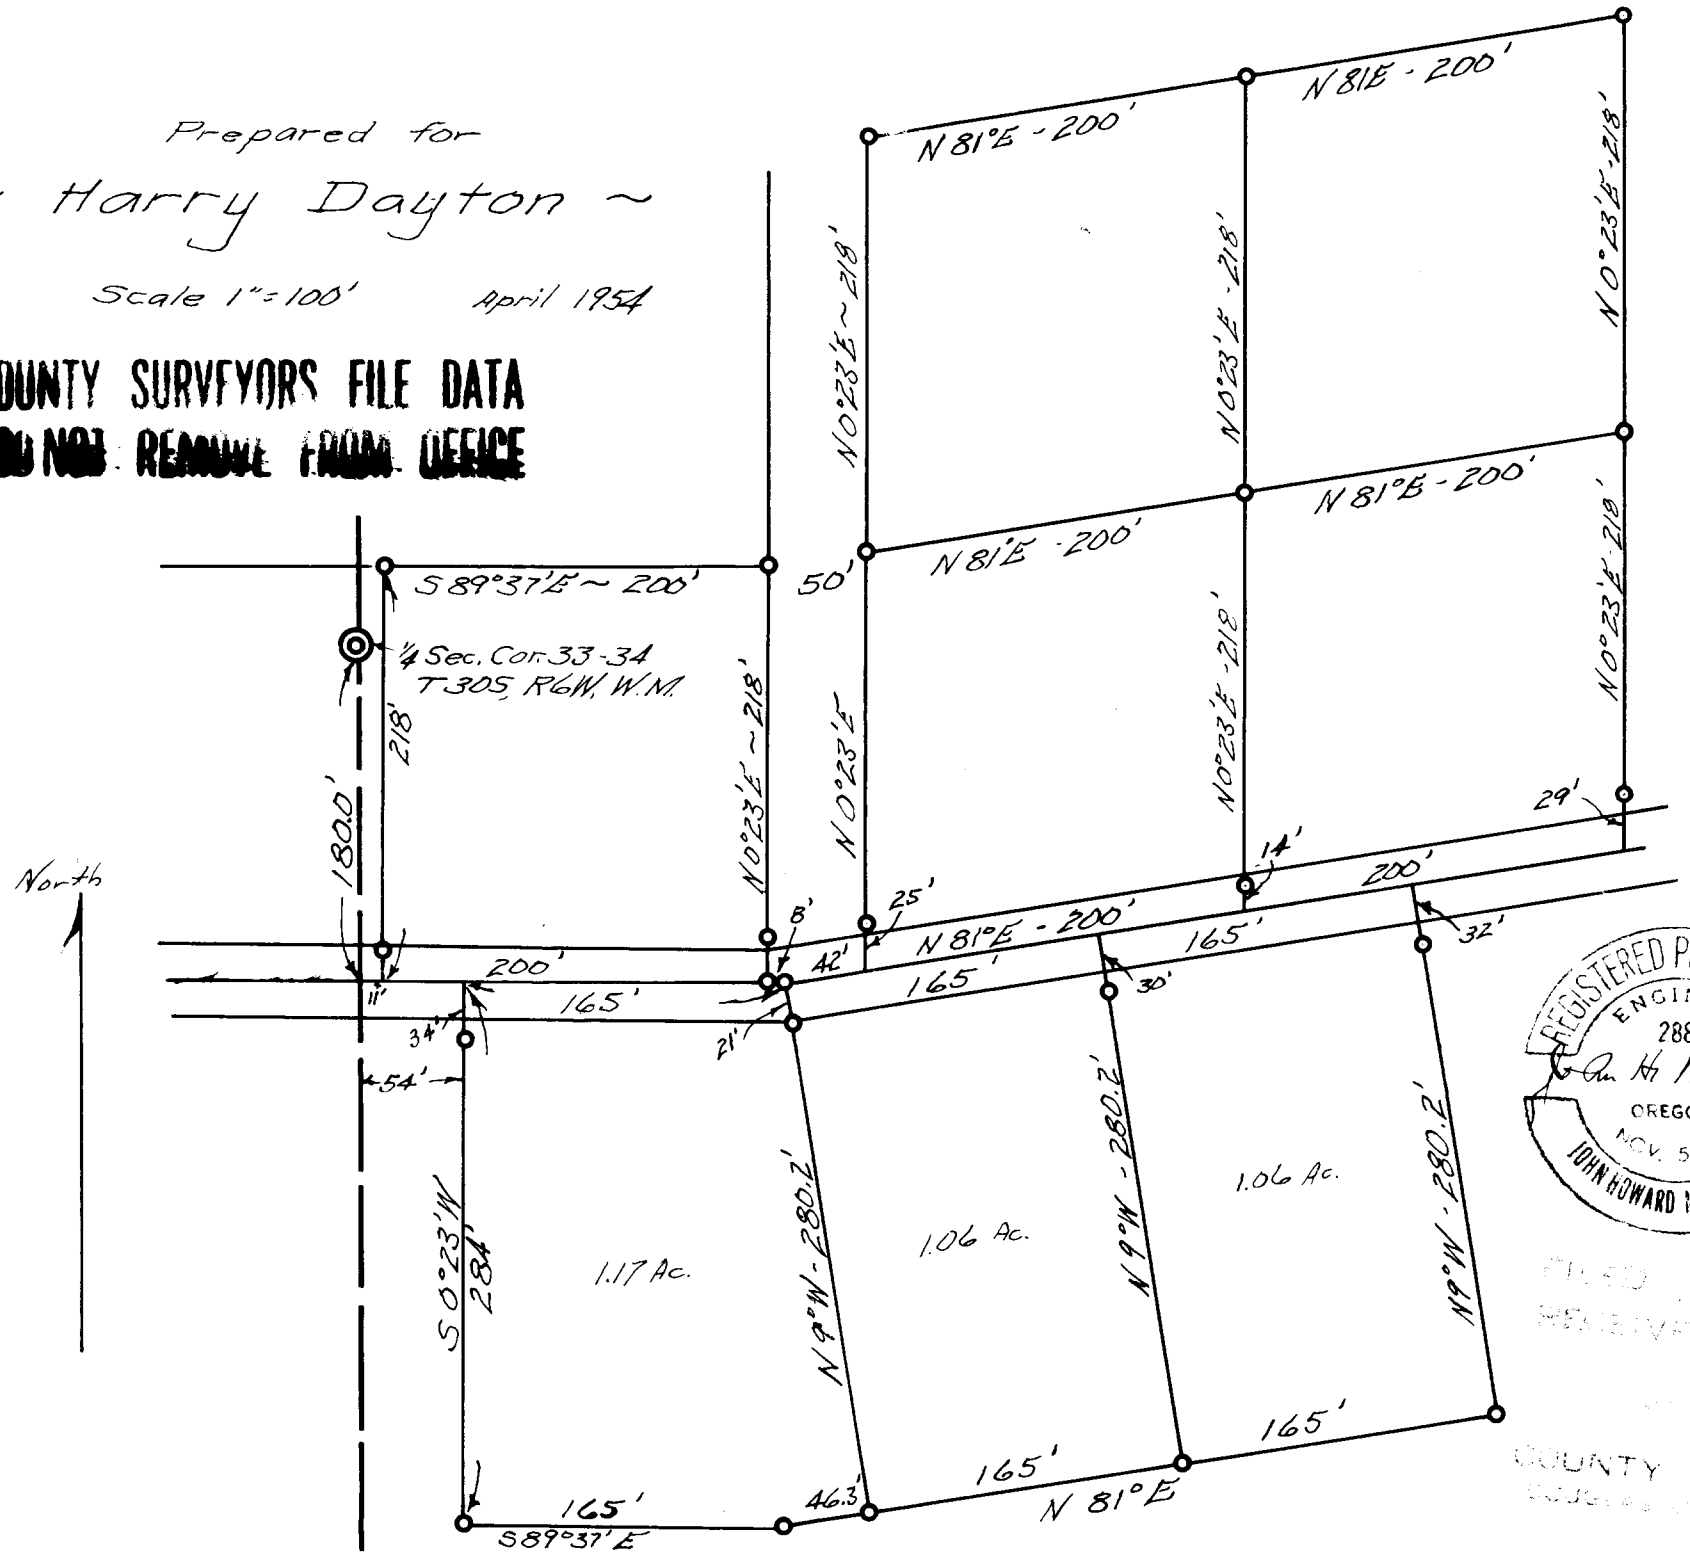

REGISTERED PROFESSIONAL ENGINEER 2880 OREGON NOV. 5, 1948 JOHN HOWARD MARNHAM JR.

FILED
RECEIVED

COUNTY SURVEYOR

P. S. Sh. No. 51/137-1