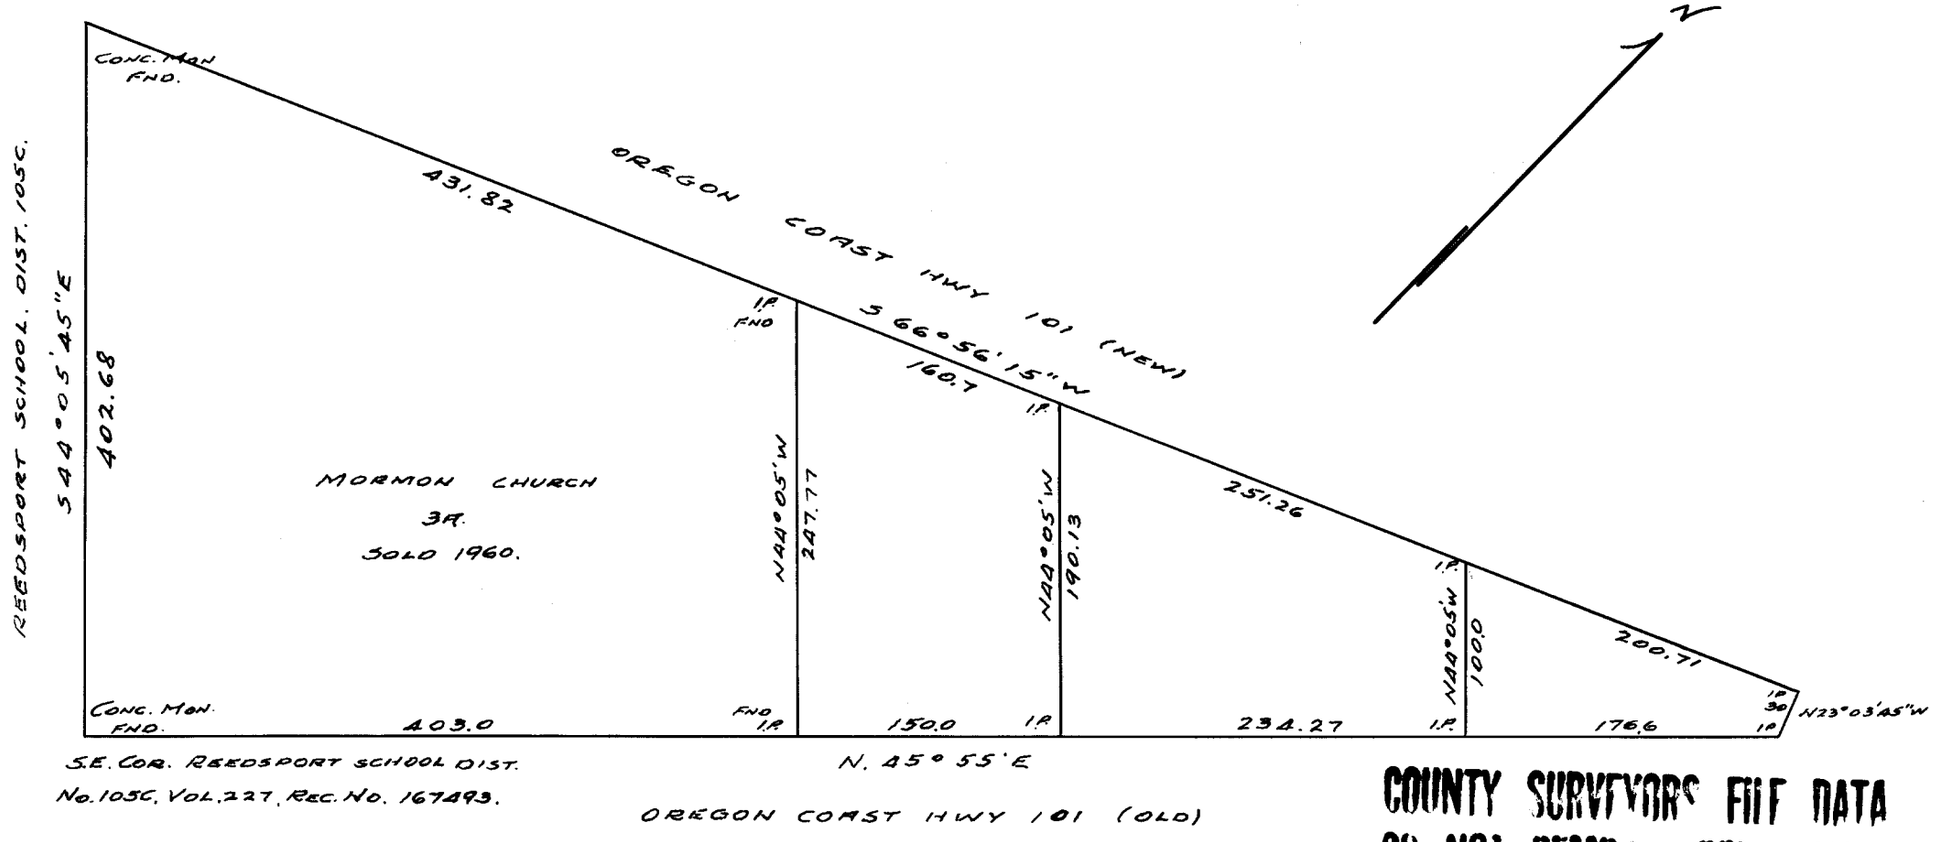

COUNTY SURVEYOR'S FILE DATA
DO NOT REMOVE FROM OFFICE

SURVEY

JOHN K HUBBARD

SEC 4, T. 22S. R. 12W. W.M.

DOUGLAS COUNTY

Scale 1" = 100' July 1961.

REGISTERED PROFESSIONAL ENGINEER
Wm. J. Brayton
OREGON
MARCH 5, 1948
WM. J. BRAYTON

FILED
RECEIVED
AUG 29 1961
COUNTY SURVEYOR
DOUGLAS COUNTY, ORE.

C.S. File No. 51/14