LOT 9 · BL. 2 · SUKSDORF COOS JUNCTION ORCHARD TRACTS

WINSTON · DOUGLAS COUNTY · OREGON

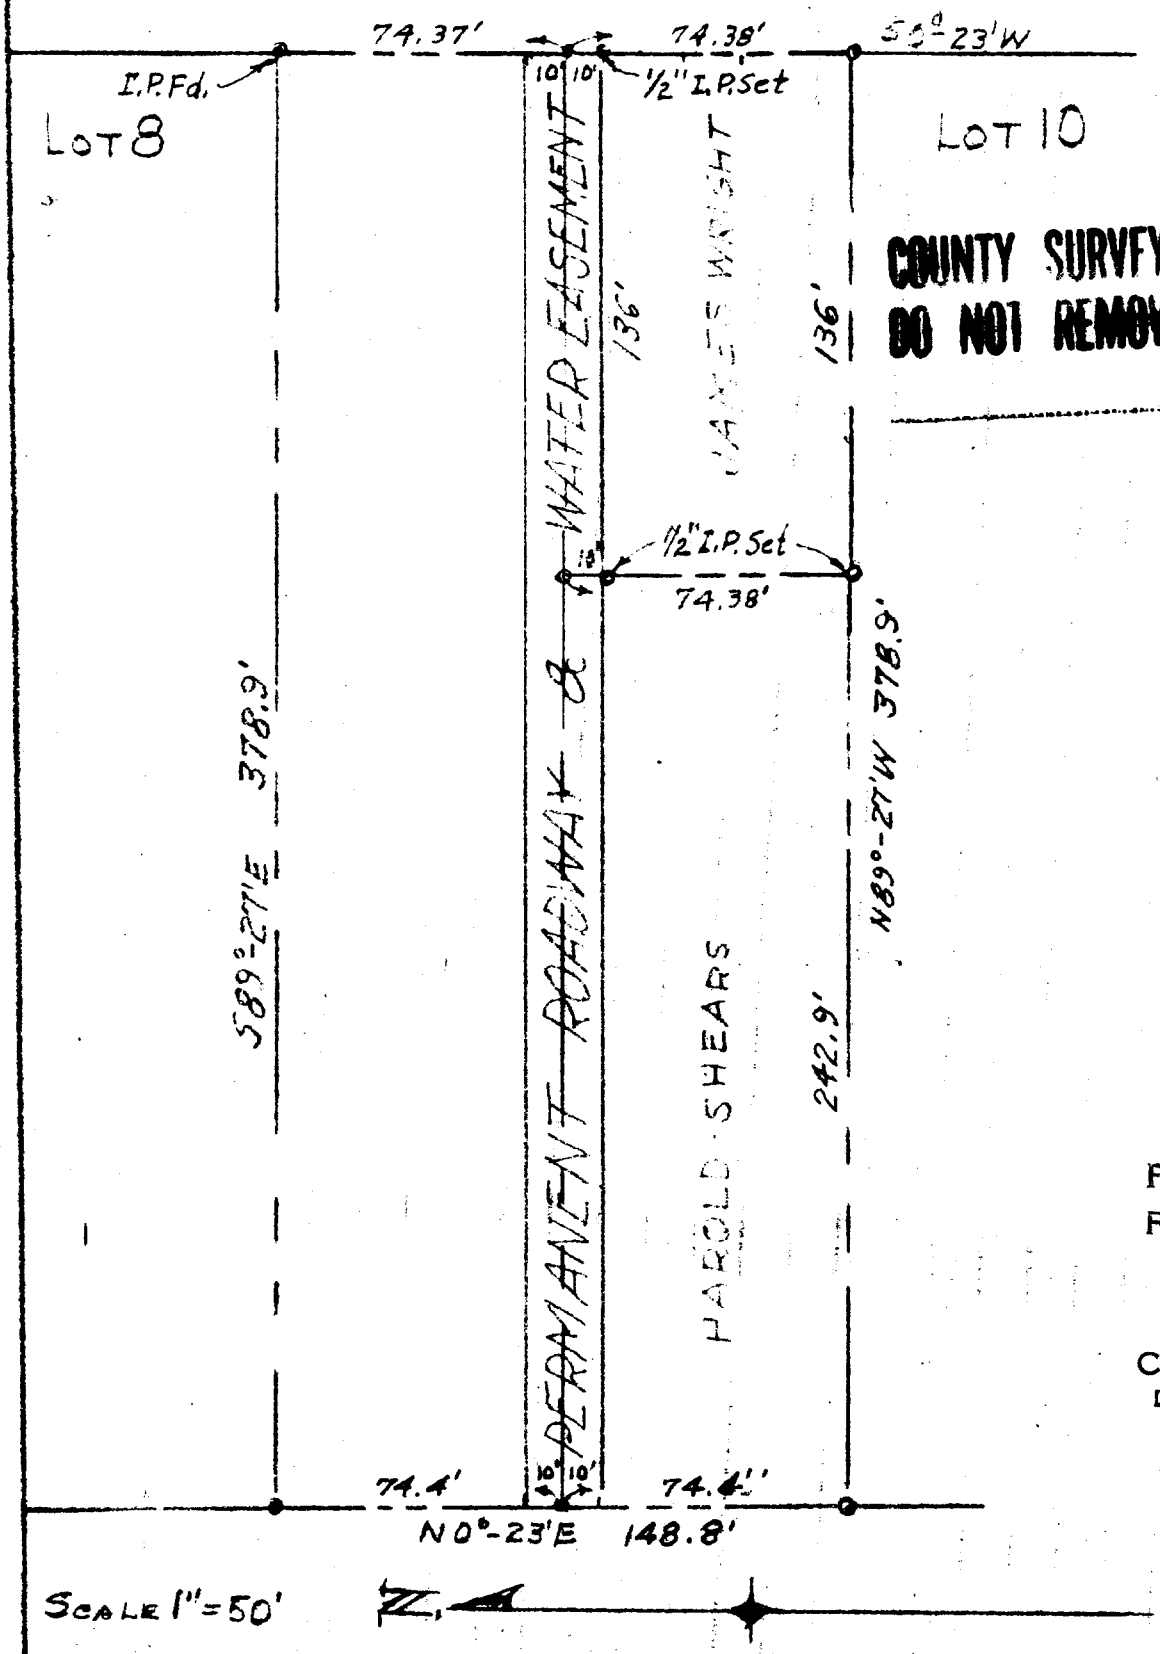

COUNTY SURVEYORS FILE DATA
DO NOT REMOVE FROM OFFICE

SURVEYED BY
JAMES R. DAUGHERTY
CIVIL-SANITARY ENGINEER
WINSTON, ORE.

FILED
RECEIVED
DEC 23 1960
COUNTY SURVEYOR
DOUGLAS COUNTY, ORE.

REGISTERED PROFESSIONAL ENGINEER
2358
James R. Daugherty
OREGON
NOV. 10, 1964
JAMES R. DAUGHERTY

OCT. 1960.

C. S. File No. 51/158