

R. 12 W

10947.326 FT.

80

70

WEST
1320

17 16
20 21

10947.186 FT.

1088.50

80

1160
535°02'E

UNNAMED LAKE

180

554°58'W
176.6

10884.026 FT.

4" POST FND.
SET BY C-Z CO.

275.29

196.29
SOUTH

COUNTY
DO NOT



T. 20 S.

FILED
RECEIVED

MAY 8, 1907

COUNTY SURVEYOR
DEULAS COUNTY, ORE.

WM. J. BRAYTON
Engineer
FLORENCE, OREGON

July 2nd 1962.

Mr. Fred M. Darby, County Surveyor,
Roseburg, Oregon.


Dear Sir:

Having been away for some time, upon my return I received the tracing of Property, Echo Resort, Inc. which I had sent in to your office for recording, along with a copy of the ORS 209.250.

May I say that this plat does not purport to be a survey, merely a plat showing the property of Echo Resort, Inc. The information was obtained from maps of Long Bell Lbr. Co, Oregon State Highway Dept, The U.S. Bureau of Public Roads and one from your office. this information I have now put on this plat, and I think this will clarify matters.

It is not with intent that I have not complied with all the regulations of ORS 209.250 and I would hate to be referred to the State Board for any infraction of its rules.

Very truly yours,

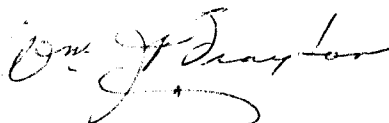

FILED
RECEIVED

JUL 3 1962

COUNTY SURVEYOR
DOUGLAS COUNTY, ORE.

51/198-2

September 11, 1961

Wm. J. Brayton

Florence

Oregon

Dear Mr. Brayton:

We are returning your most recent survey with the request that you include a tie to the Meander Corner or some other government corner.

Thank you in advance for your cooperation.

Very truly yours,

Fred M. Darby

County Surveyor

Lorraine R. Lewis, Deputy

CS 51/198-2C