COUNTY SURVEYORS FILE DATA
DO NOT REMOVE FROM OFFICE

SURVEY OF PORTION OF LOT 139 PLAT I TRACT I ROSEBURG ORCHARDS COMPANY SEC. 7, T27S R5W, W.M.

FILED
RECEIVED L.L.
AUG 14 '61
COUNTY SURVEYOR
DOUGLAS COUNTY, ORE.

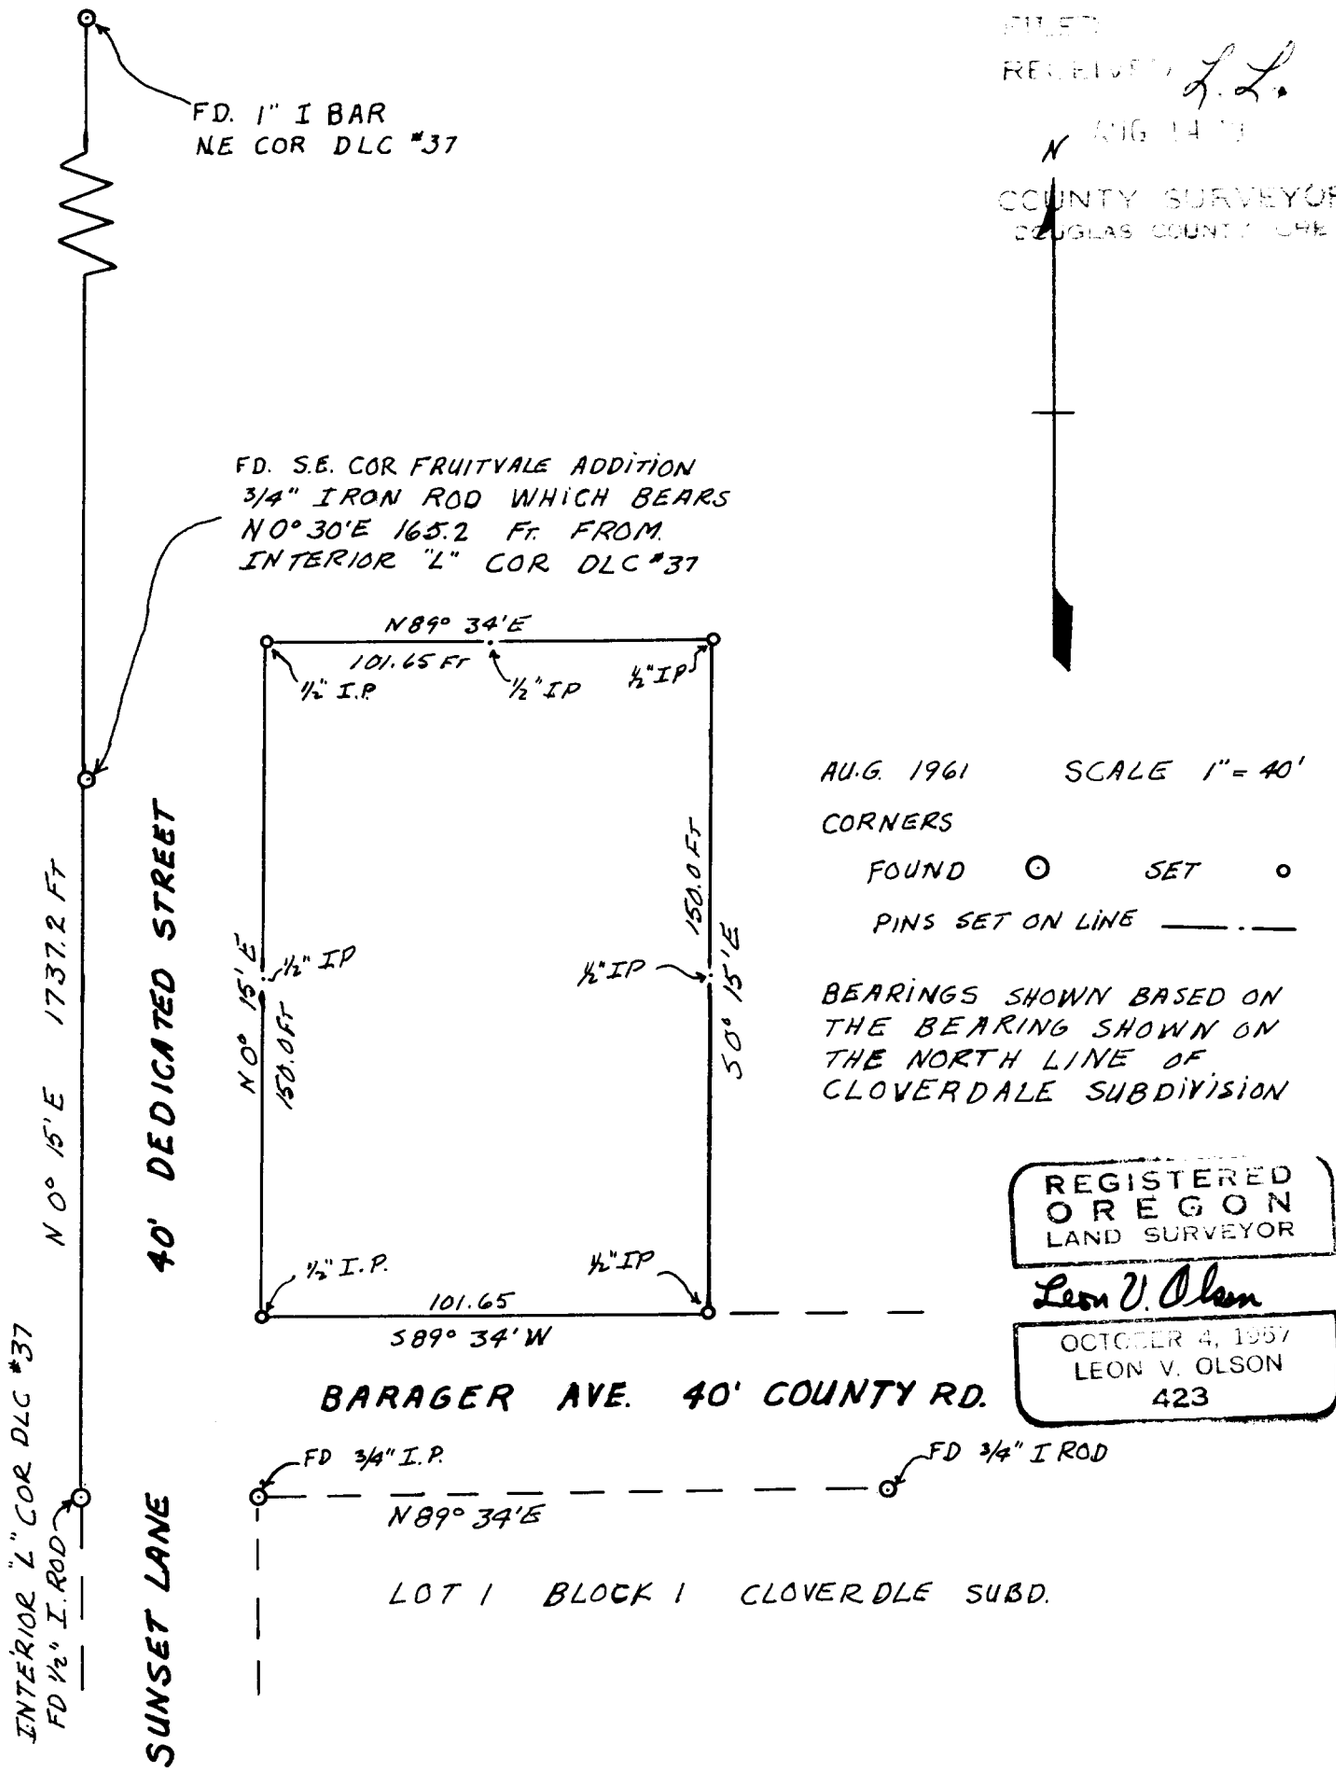

AUG. 1961 SCALE 1" = 40'

CORNERS

FOUND ⊙ SET ○

PINS SET ON LINE ——.——

BEARINGS SHOWN BASED ON THE BEARING SHOWN ON THE NORTH LINE OF CLOVERDALE SUBDIVISION

REGISTERED
OREGON
LAND SURVEYOR
Leon V. Olson
OCTOBER 4, 1957
LEON V. OLSON
423

C.S. No. 51/210