COUNTY SURVEYOR'S FILE DATA
DO NOT REMOVE FROM OFFICE

SURVEY IN FIRST ADDITION TO WEST SLOPES IN D.L.C. 53, T. 27 S., R. 6 W., W. M.

SURVEYED FOR: CECIL LUELLEN — OCTOBER, 1961

SURVEYED BY: G. R. LECKLIDER - ENGINEER — SCALE: 1" = 60'

○ DENOTES 5/8" IRON ROD SET UNLESS OTHERWISE NOTED
● DENOTES 1/2" IRON ROD FOUND UNLESS OTHERWISE NOTED

FILED
RECEIVED
COUNTY SURVEYOR
DOUGLAS COUNTY, ORE.

REGISTERED PROFESSIONAL ENGINEER 4079 OREGON OCT. 15, 1956 G. ROBERT LECKLIDER

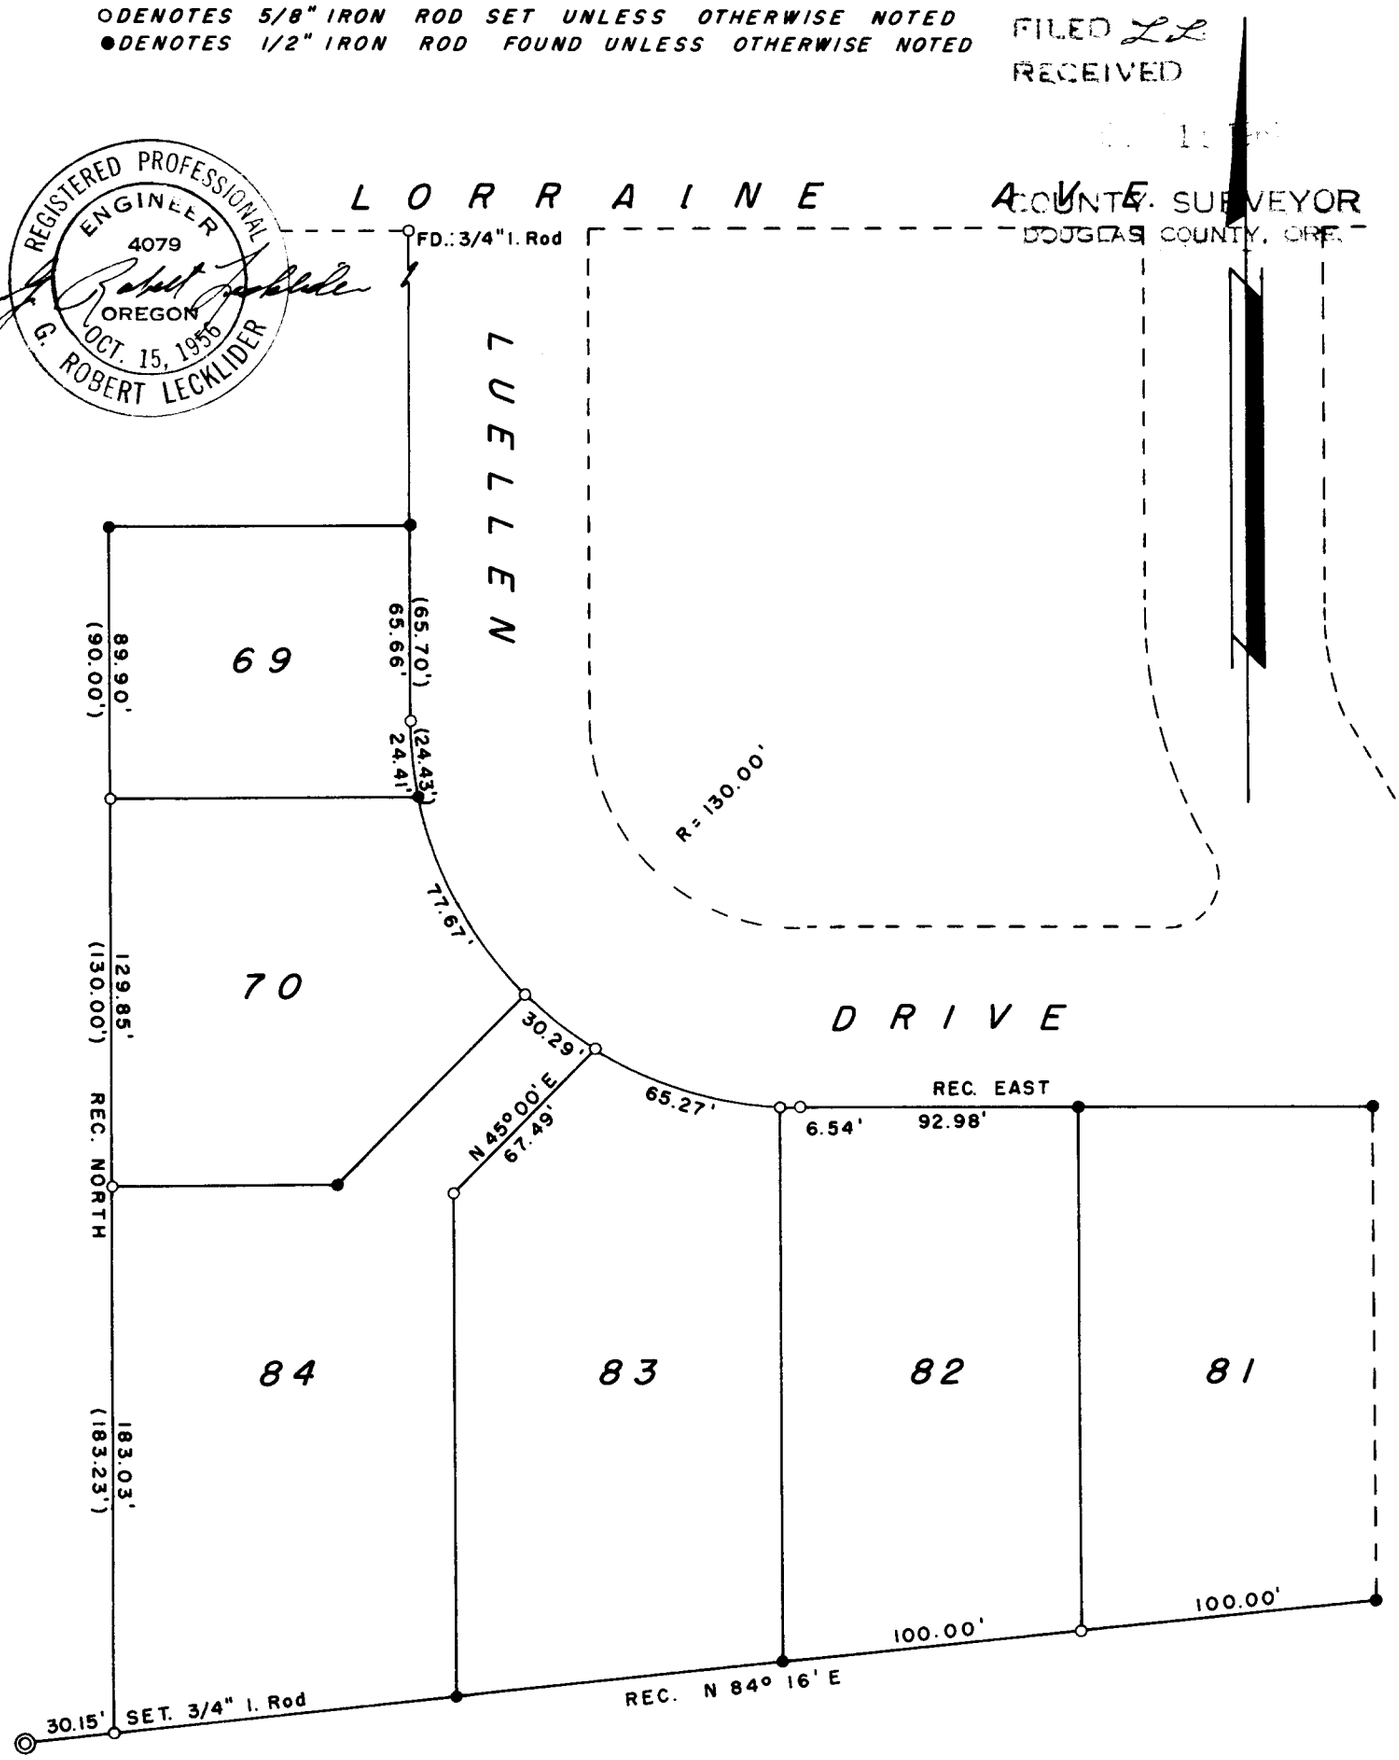

C. S. File No. 51/215-4