

# JOHANNA TEUBNER PARCEL

DOUGLAS CO. ORE.

T 28 S • R 6 W • W 1 M *Sec. 6*

LADUKE

20' 33"

1 1/8 FD.

S 1°-15' E 805.7'

1/2 I.P. Set  
S 41° 30' W 12' W OAK  
S 74° E 33'

JOHANNA TEUBNER  
1/2 ± ACRES

HAPPY VALLEY COUNTY ROAD NO. 20

WEST

1444.2'

1/2 I.P. Set

423.4'

COUNTY SURVEYORS FILE DATA  
DO NOT REMOVE FROM OFFICE

FILED *L.L.*  
RECEIVED

MAR 19 1962

COUNTY SURVEYOR  
DOUGLAS COUNTY, ORE.




Surveyed By

JAMES R. DAUGHERTY  
CIVIL-SANITARY ENGINEER  
WINSTON, OREGON

SCALE 1" = 200'  
MARCH 16, 1952

D.L.C. NO. 40  
FD. 6" S 2. ST. 10

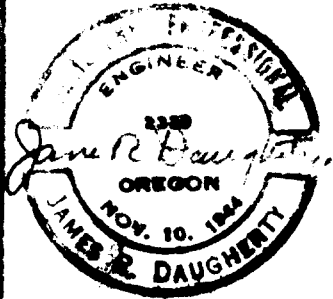

EDW