FLOYD HOFFMAN PARCEL · MILITARY AVE. · W. ROSEBURG

T. 27-6 Sec. 23

SURVEYED BY

JAMES R. DAUGHERTY
CIVIL-SANITARY ENGINEER
WINSTON · ORE.

FILED
RECEIVED
JUN 1 1961
COUNTY SURVEYOR
DOUGLAS COUNTY, ORE.

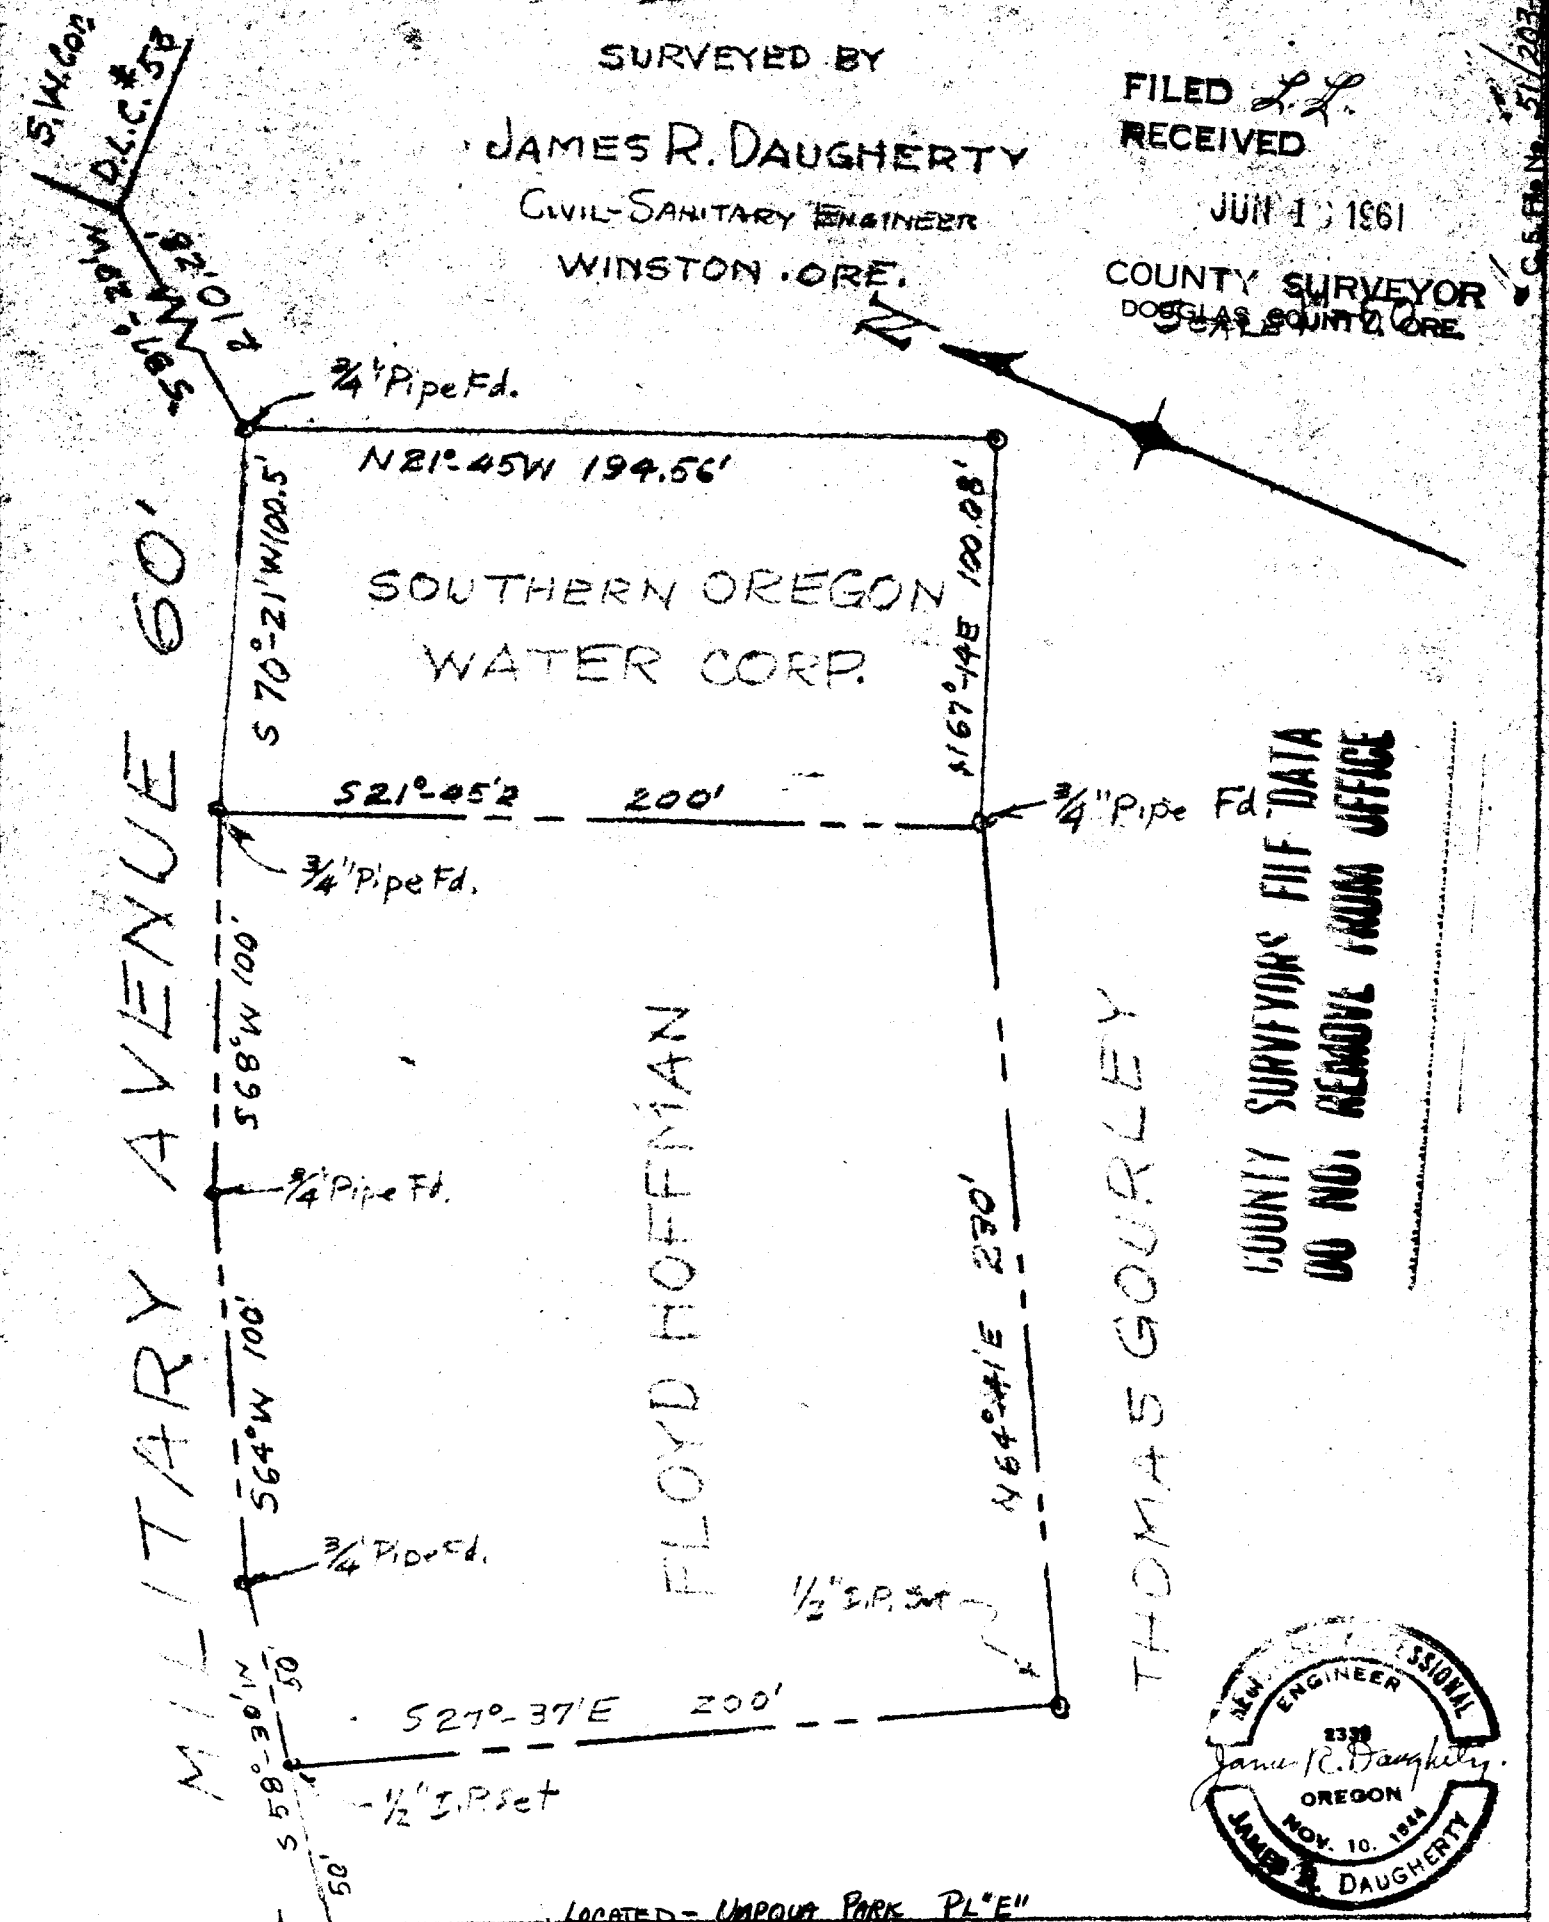

COUNTY SURVEYOR'S FILE DATA
DO NOT REMOVE FROM OFFICE

LOCATED - UMPQUA PARK PL "E"

N 8 5