COUNTY SURVEYOR'S FILE DATA
DO NOT REMOVE FROM OFFICE

SURVEY TO ESTABLISH PROPERTY CORNERS IN "SHORT ACRES," SECTION 16, T27S, R6W, W.M.

JANUARY, 1962 SCALE: 1" = 100'

G. R. LECKLIDER-ENGINEER

FILED
RECEIVED
FEB 1 1962
COUNTY SURVEYOR
DOUGLAS COUNTY, ORE.

REGISTERED PROFESSIONAL ENGINEER 4079 OREGON OCT. 15, 1956 G. ROBERT LECKLIDER

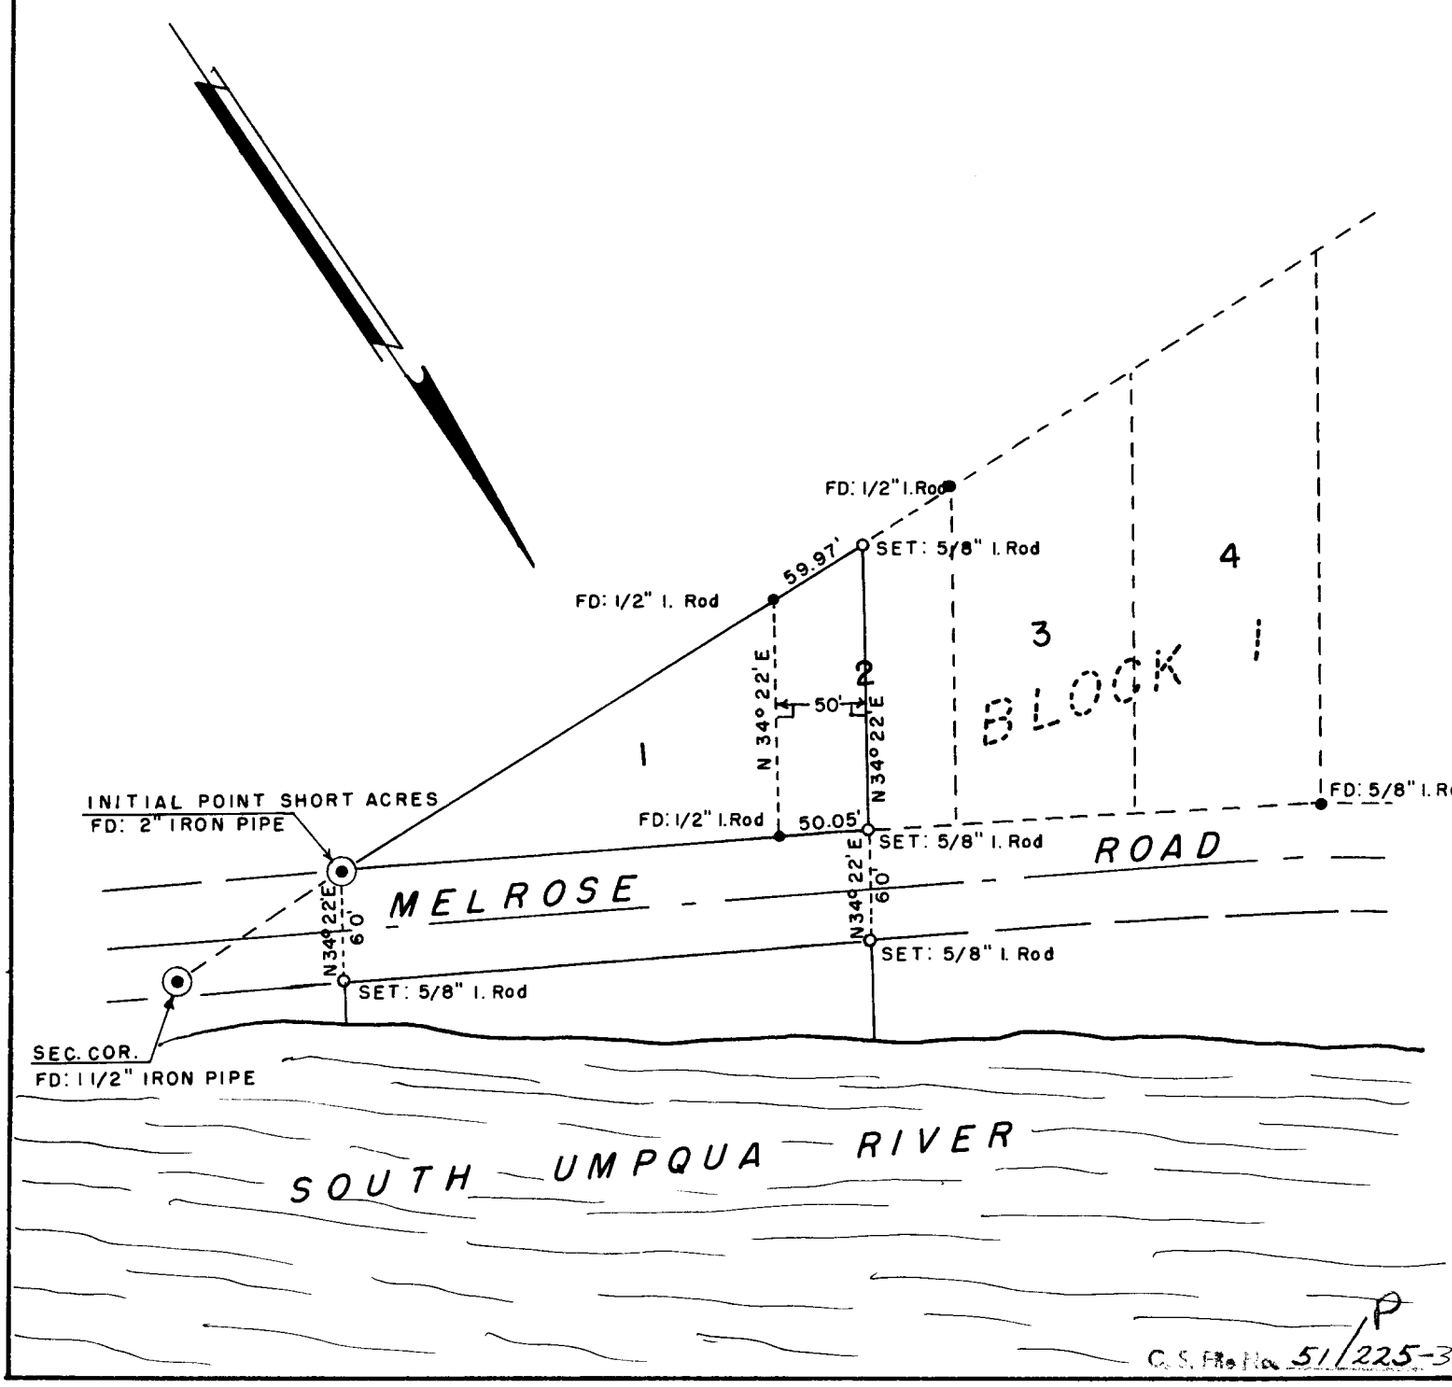

C. S. File No. 51/225-3