COUNTY SURVEYOR'S FILE DATA
DO NOT REMOVE FROM OFFICE

SURVEY IN
D.L.C. No. 38, T28S, R8W & D.L.C. No. 59, T28S, R7W, W.M.

SURVEYED FOR: VIRGIL C. VANCE
SURVEYED BY: G. R. LECKLIDER-ENGINEER

MARCH, 1962
SCALE: 1" = 100'

DENOTES 5/8" IRON RODS SET.
BEARINGS BASED ON NORTH LINE D.L.C. 38 & D.L.C. 59 AS PER COLE SURVEY IN C.S. FILE 58.-M 1-2

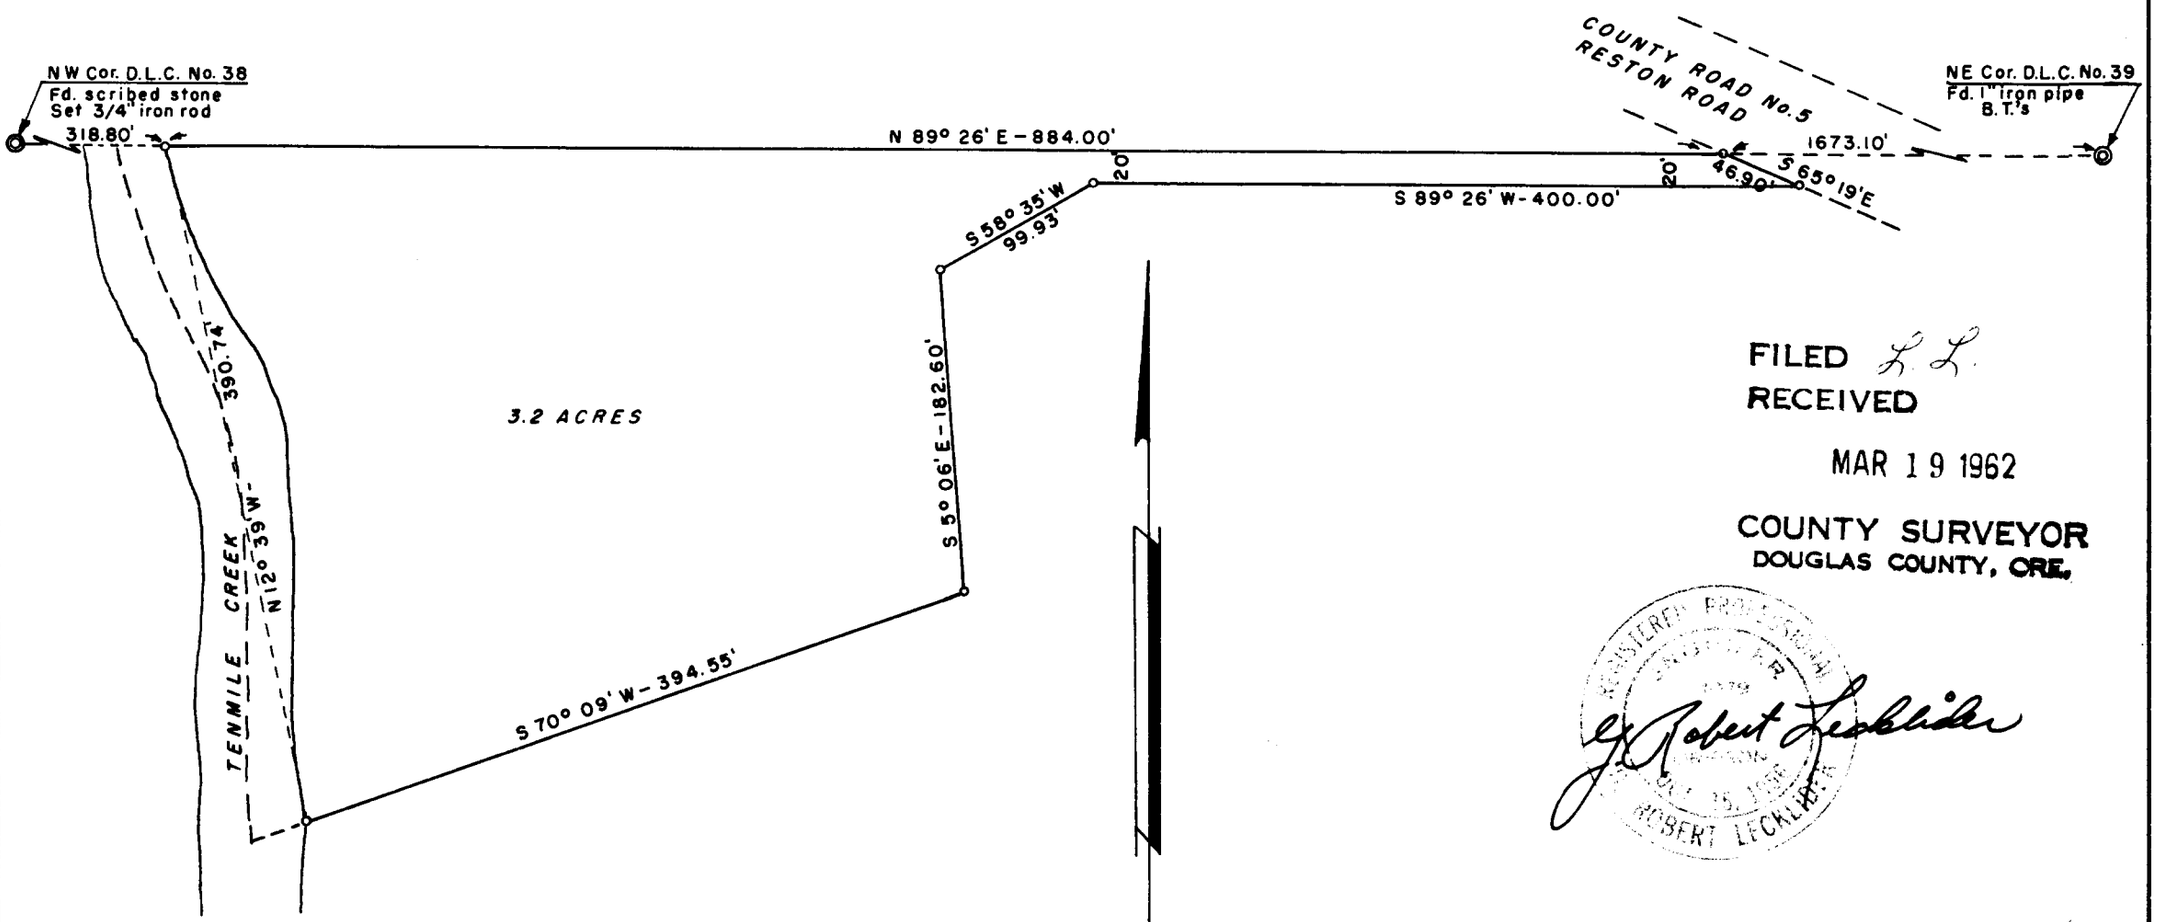

FILED L. L.
RECEIVED
MAR 19 1962
COUNTY SURVEYOR
DOUGLAS COUNTY, ORE.

REGISTERED PROFESSIONAL ENGINEER
1979
OREGON
OCT 29 1968
ROBERT LECKLIDER

G. Robert Lecklider

No. 51/230-2