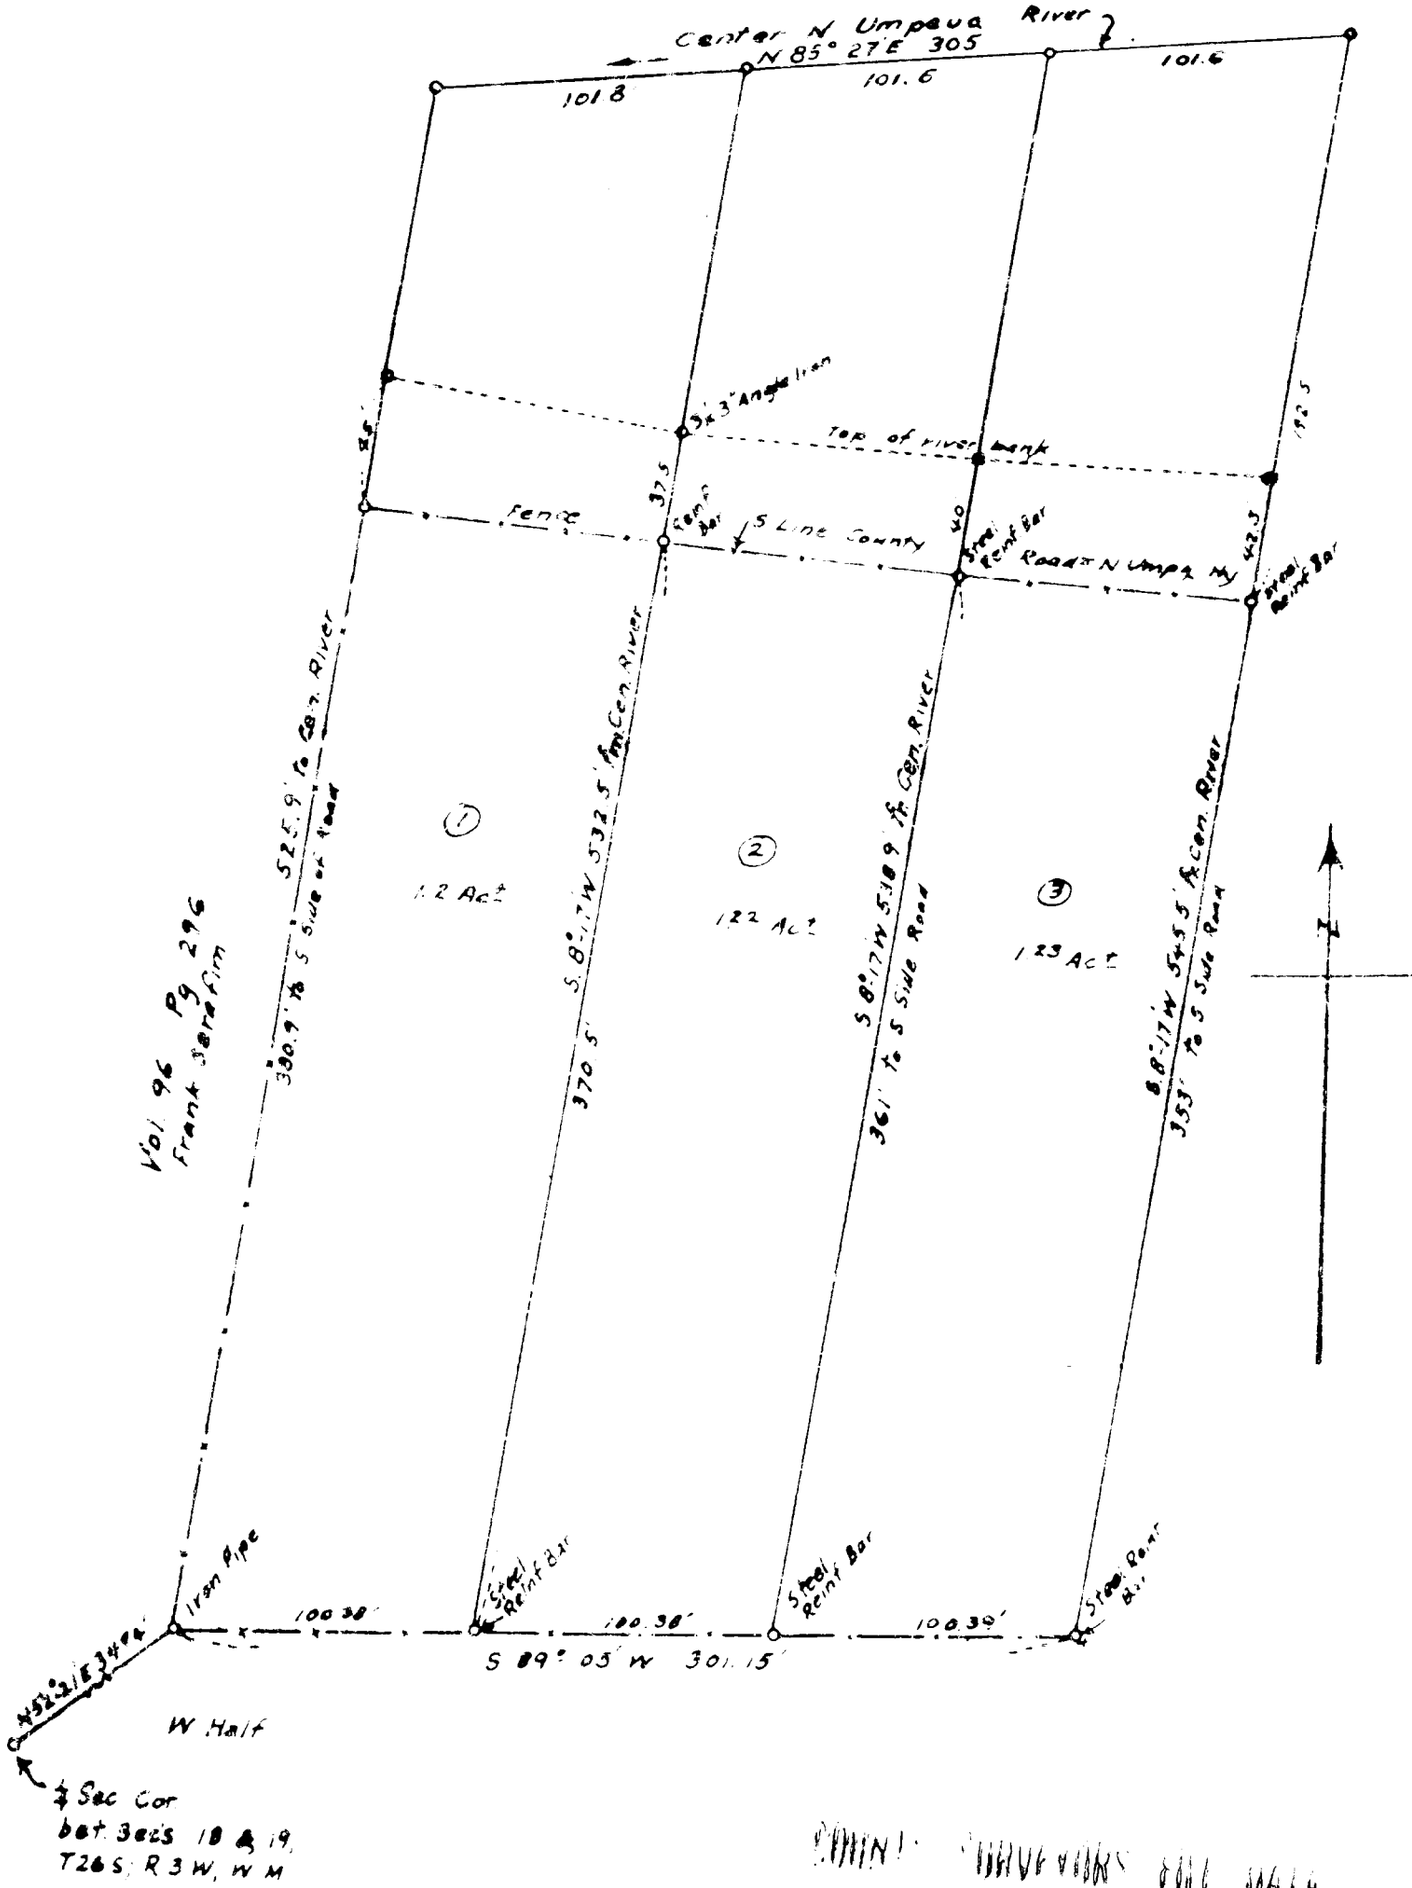

FILED
RECEIVED
NOV 21 1962
COUNTY SURVEYOR
DOUGLAS COUNTY, ORE.

VAUGHN PROPERTY
SEC 17, T.26S; R.3W; W.M.
JULY 1950 D.Bayer 1"=60'

C.S. File 51/2