WILLIFORD AND SHEPHERD PARCELS LOTS 6,7 & 8

UNRECORDED PLAT OF CHESTER FISHER RANCH IN SEC. 23 · T26S · R6W · W.M.

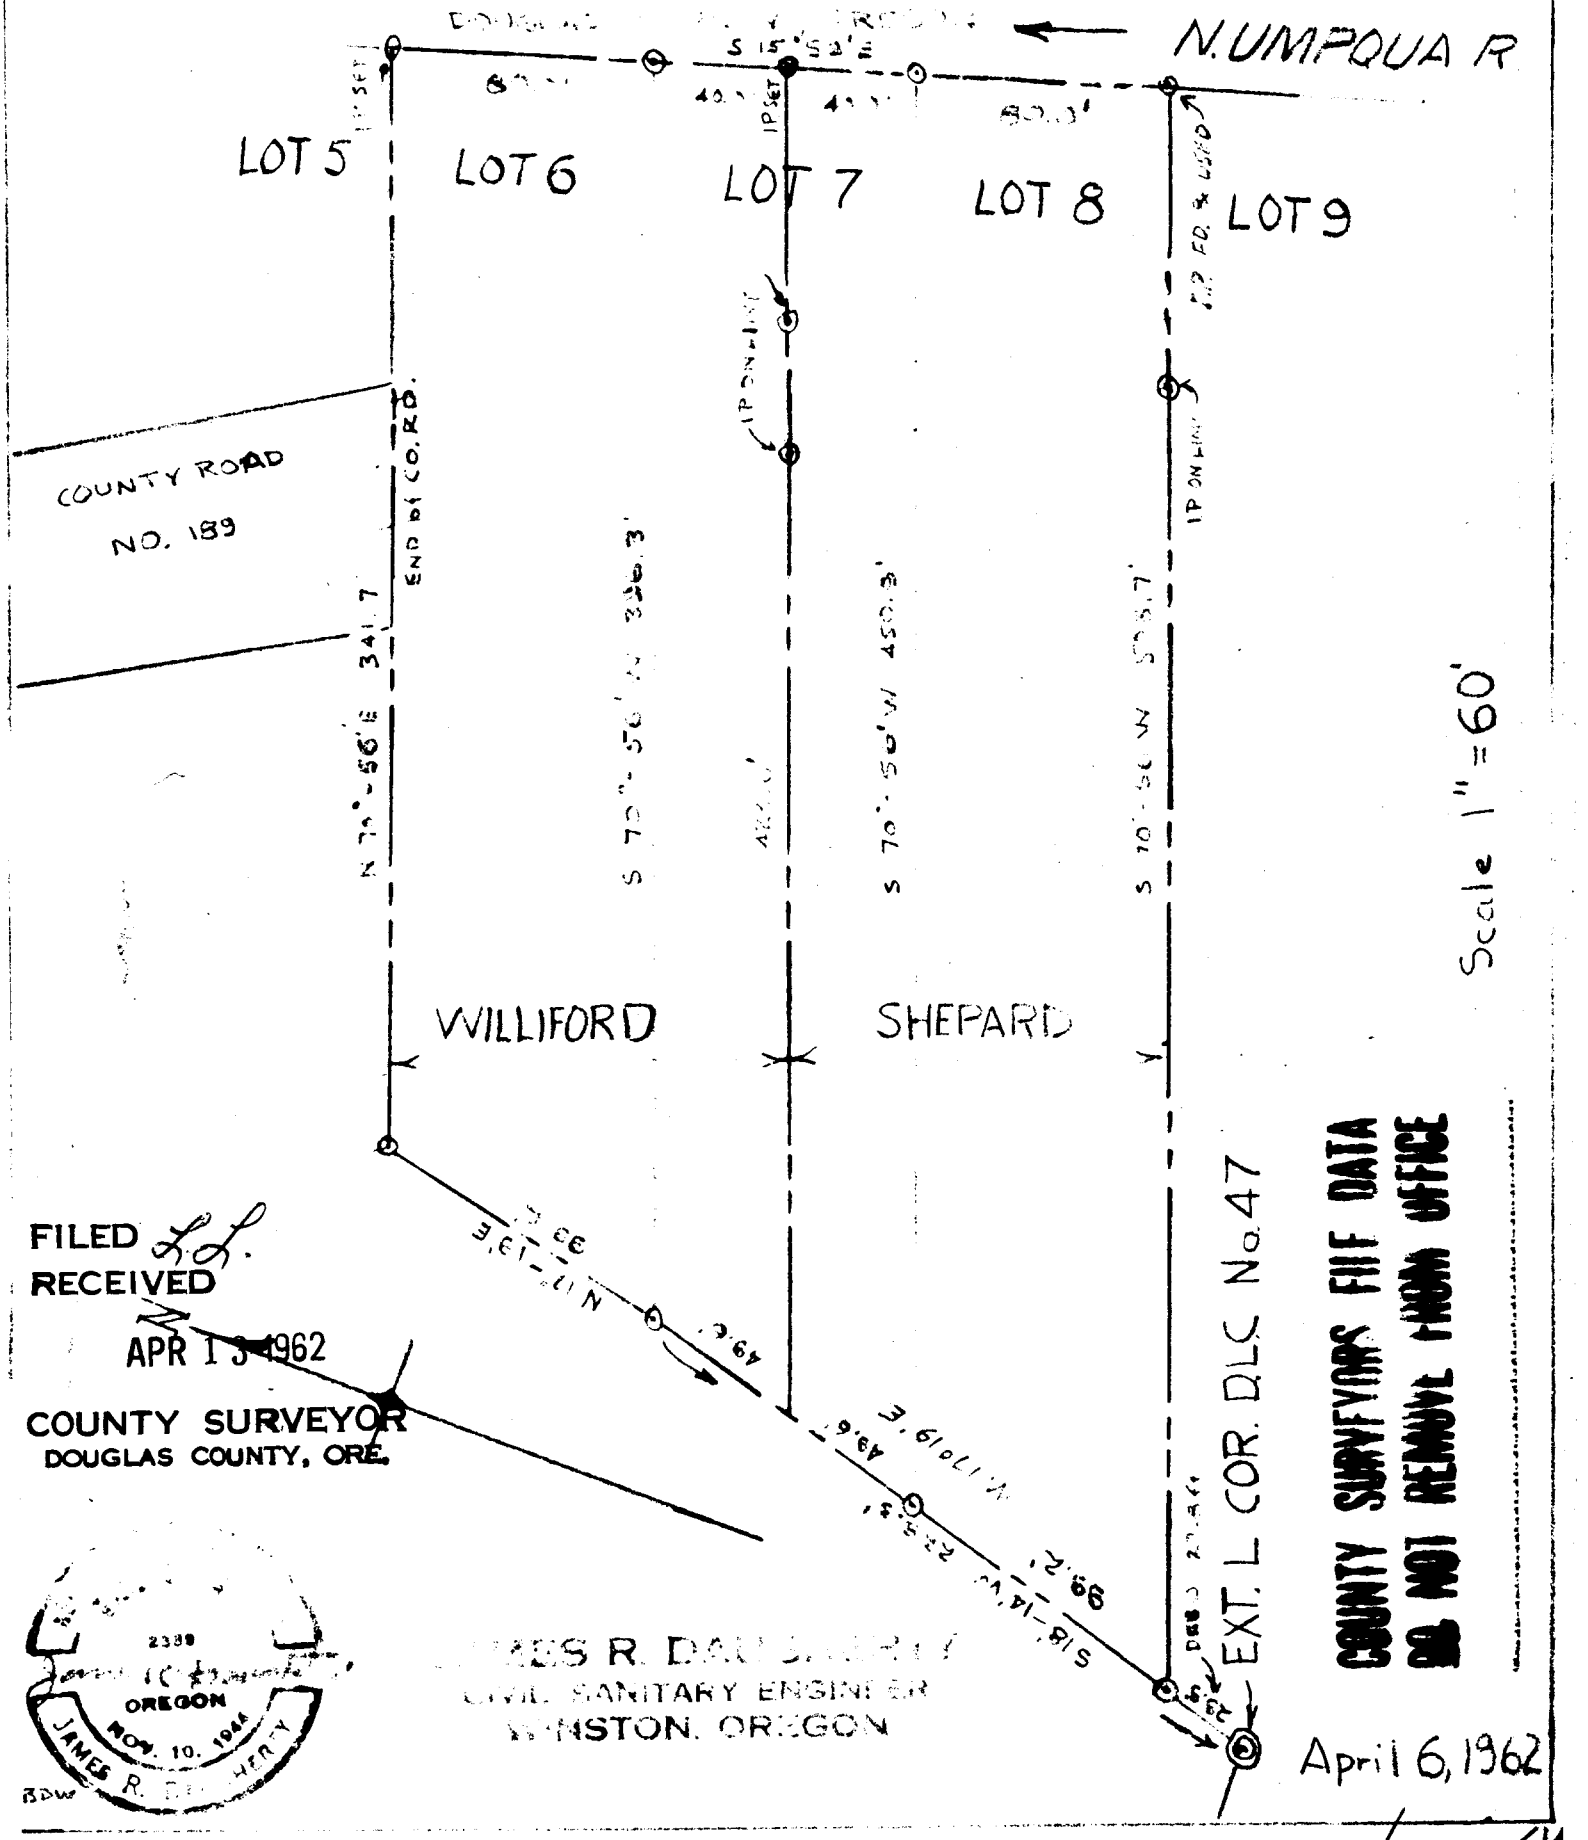

G. S. File No. 51/232-1