

ROSEBURG RURAL FIRE PROTECTION DIST. STATION #2

DOUGLAS COUNTY OREGON
LOT 10 LOT 9

LOT 27

GREEN AVENUE 60' $\frac{1}{2}$ " PIPE FD. $\frac{3}{4}$ " Bar Fd.

CO. ROAD 110

S89°-31'E 173.9' $\frac{1}{2}$ " I.P. Set 1" Bar Fd. AND USED

**COUNTY SURVEYORS FILE DATA
DO NOT REMOVE FROM OFFICE**

ROSEBURG RURAL FIRE PROTECTION DIST.
STATION NO. 2
2.8 AC.

N 7°-46'-W 700'

57°-46'E 700' COUNTY ROAD NO. 16



FILED
RECEIVED

MAY 7 1962


COUNTY SURVEYOR
DOUGLAS COUNTY, ORE.

Scale $\frac{1"}{200'}$ *1" = 100'*
April 27, 1962

$\frac{1}{2}$ " I.P. Set 173.9' N89°-31'W $\frac{5}{8}$ " I.P. Set

209.3' CARNES ROAD

PIPE FD AND USED

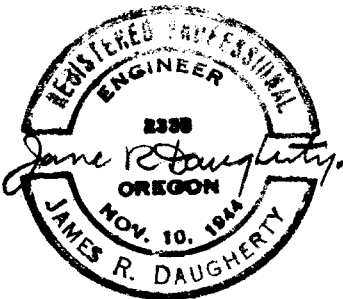

JAMES R. DAUGHERTY
CIVIL-SANITARY ENGINEER
WINSTON, OREGON

154

T28-6W. SEC. 11