T.28-6 Sec. 21AD

PARCELS IN LOT 7-BL.2-SUKSDORF

CITY OF WINSTON, OREGON

COOS JUNCTION HILL TRACTS

James LaCava

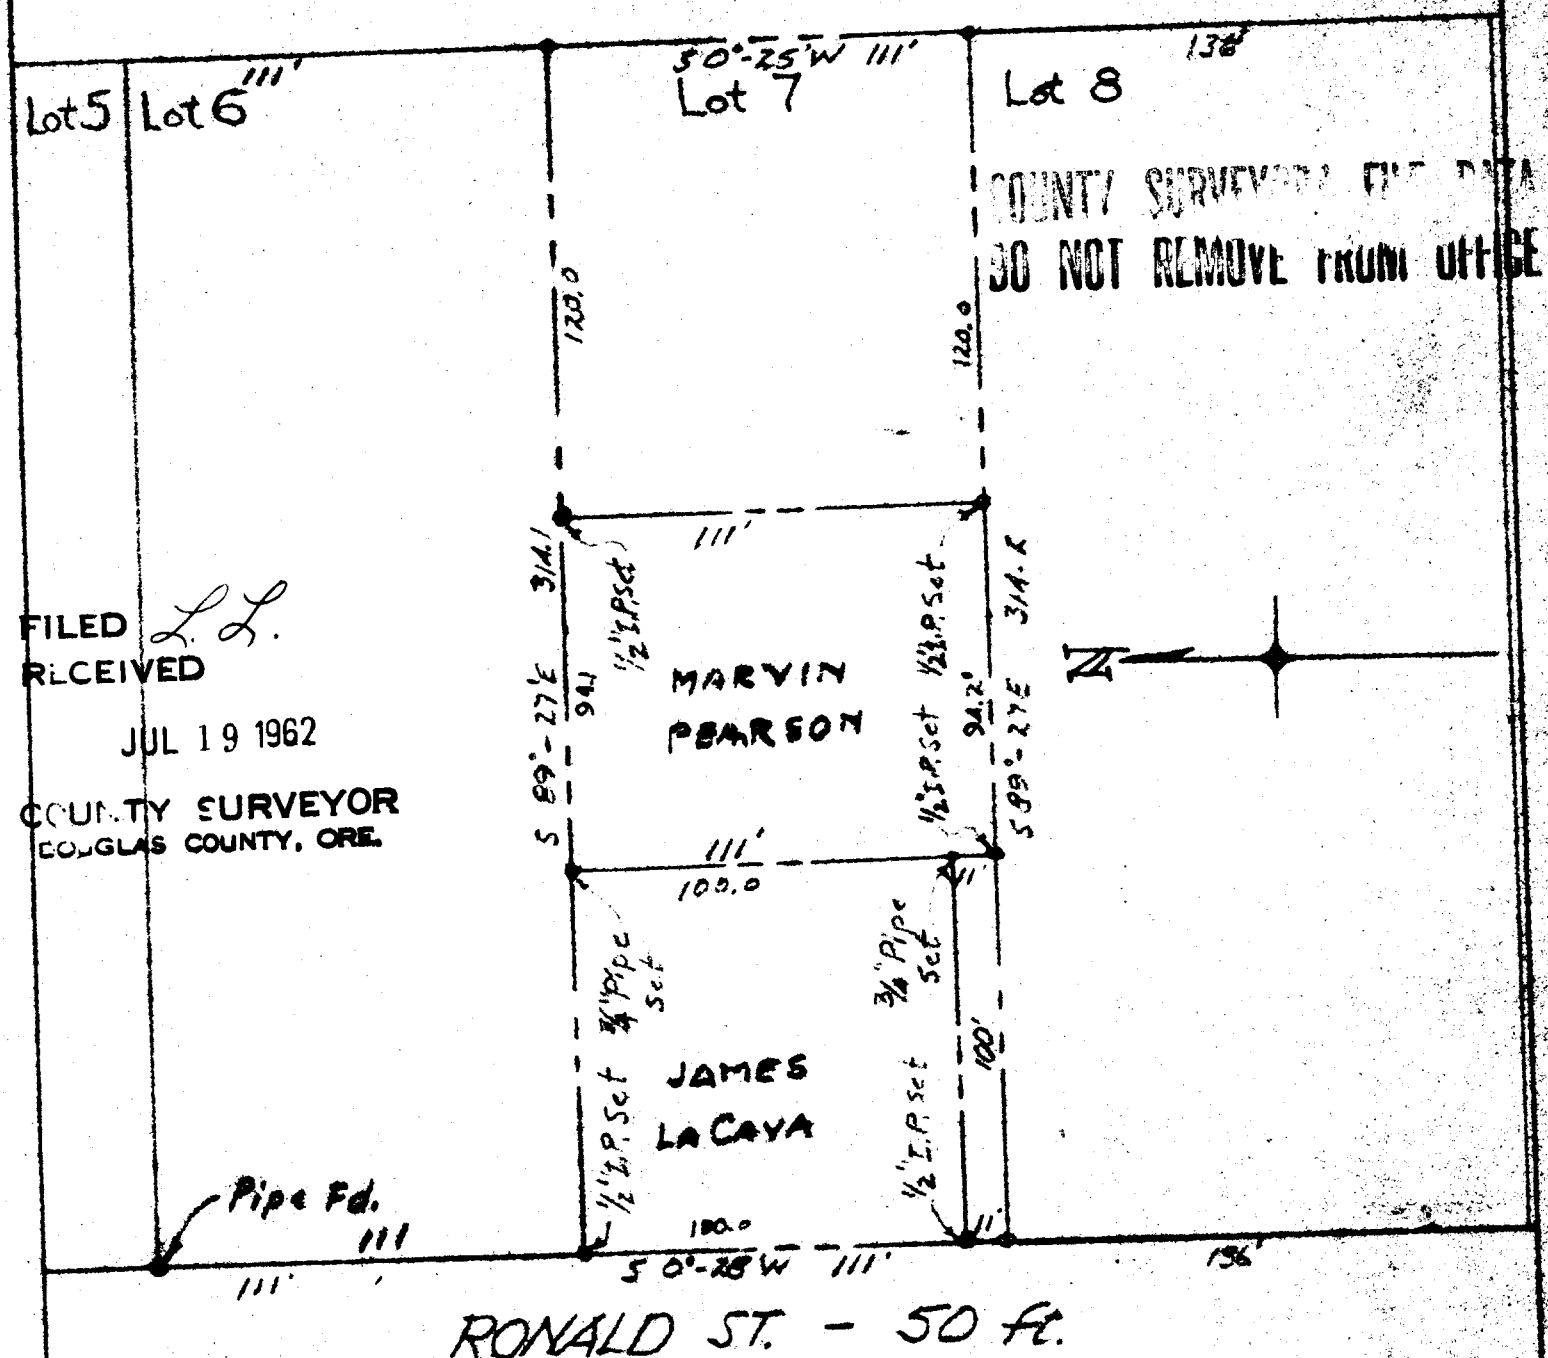

COUNTY SURVEYOR'S FILE DATA
DO NOT REMOVE FROM OFFICE

FILED L.L.
RECEIVED
JUL 19 1962
COUNTY SURVEYOR
DOUGLAS COUNTY, ORE.

RONALD ST. - 50 ft.

JAMES R. DAUGHERTY
CIVIL-SANITARY ENGINEER
WINSTON, OREGON

REGISTERED PROFESSIONAL ENGINEER
2288
OREGON
NOV. 10, 1964
JAMES R. DAUGHERTY

Scale 1" = 50'
July 13, 1962

C.S. File No. 57/24