

COUNTY SURVEYOR'S OFFICE
DO NOT REMOVE FROM OFFICE

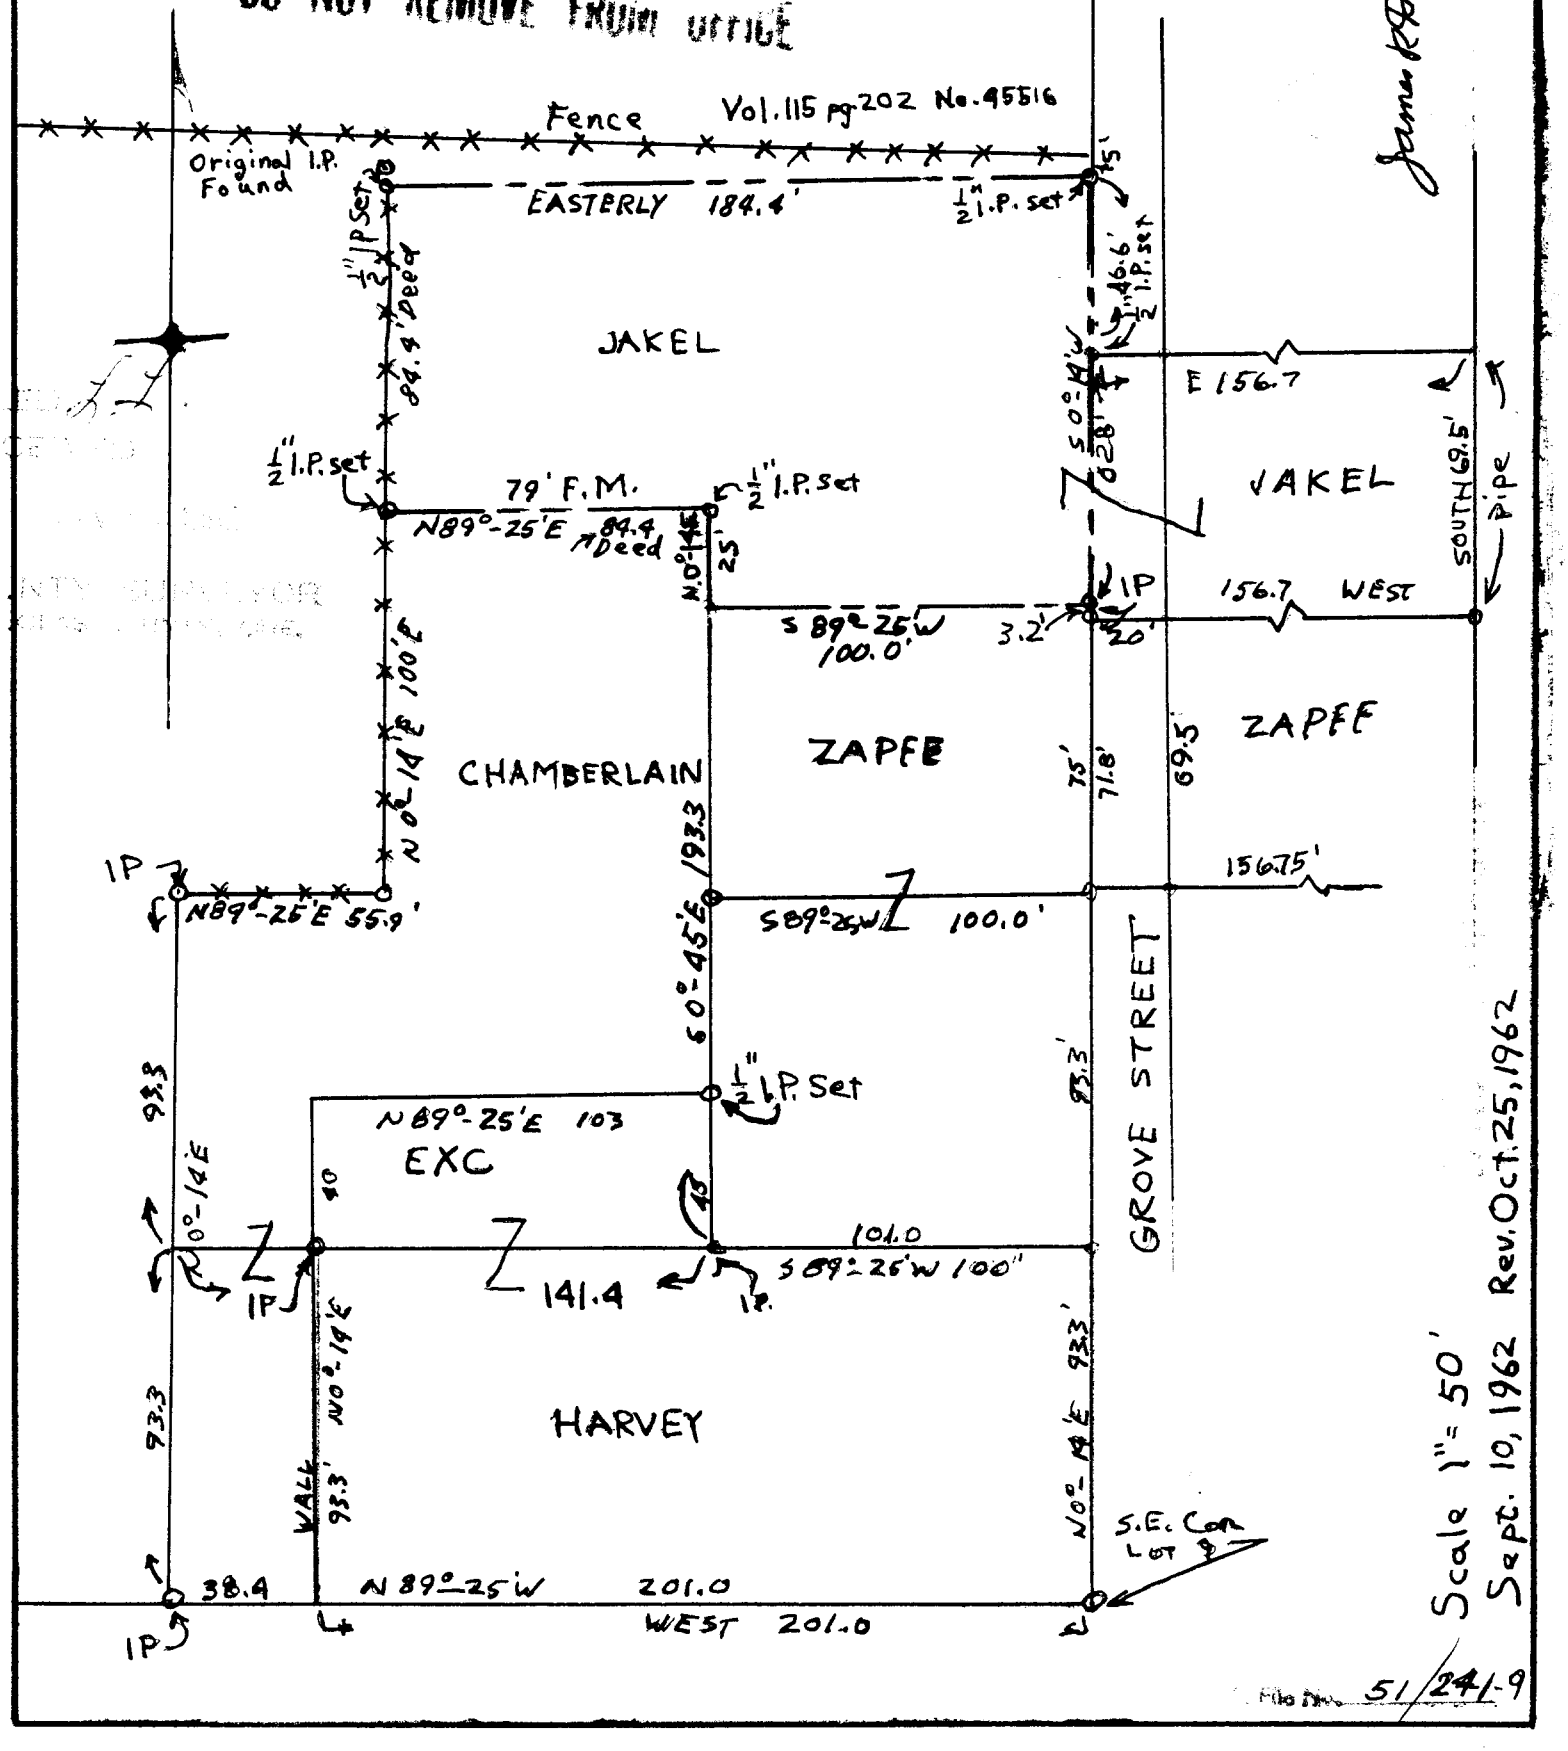

File No. 51/241-9