COUNTY SURVEYORS FILE DATA
DO NOT REMOVE FROM OFFICE

FILED
RECEIVED
RECEIVED
FEB 25 1963
COUNTY SURVEYOR
DOUGLAS COUNTY, ORE.

SURVEY OF LOT 8, EXCEPTING THE NORTHERLY 20 FEET, JOHNSON ADDITION TO REEDSPORT DOUGLAS COUNTY, OREGON

for

C. D. FURLOTT

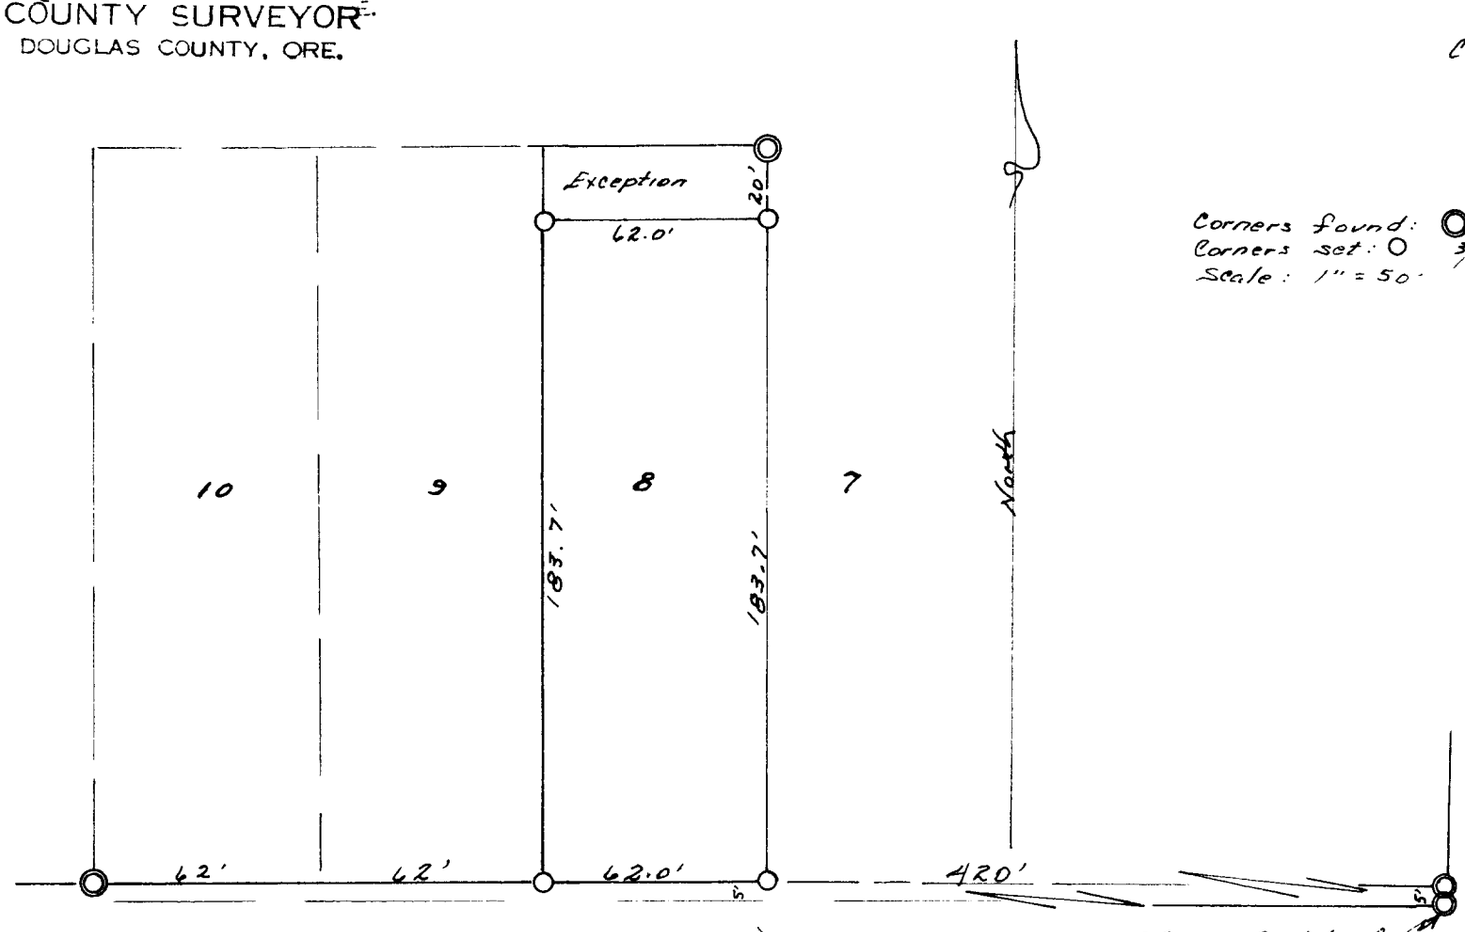

Corners found: ◎ 3/4" pipe
Corners set: ○ 3/4" pipe
Scale: 1" = 50'

February 18, 1963

REGISTERED
OREGON
Warren A. Hartman
1329

51/2