COUNTY SURVEYORS FILE DATA
DO NOT REMOVE FROM OFFICE

# SURVEY OF LOT 9, BLOCK 56, AMENDED PLAT OF RAILROAD ADDITION TO REEDSPORT, DOUGLAS COUNTY, OREGON

FILED
RECEIVED
FEB 25 1963
COUNTY SURVEYOR
DOUGLAS COUNTY, ORE.

for: C. D. FURLOTT

Corners found: ◎ 3/4" pipe
Corners set: ○
Scale: 1" = 100'
February 18, 1963

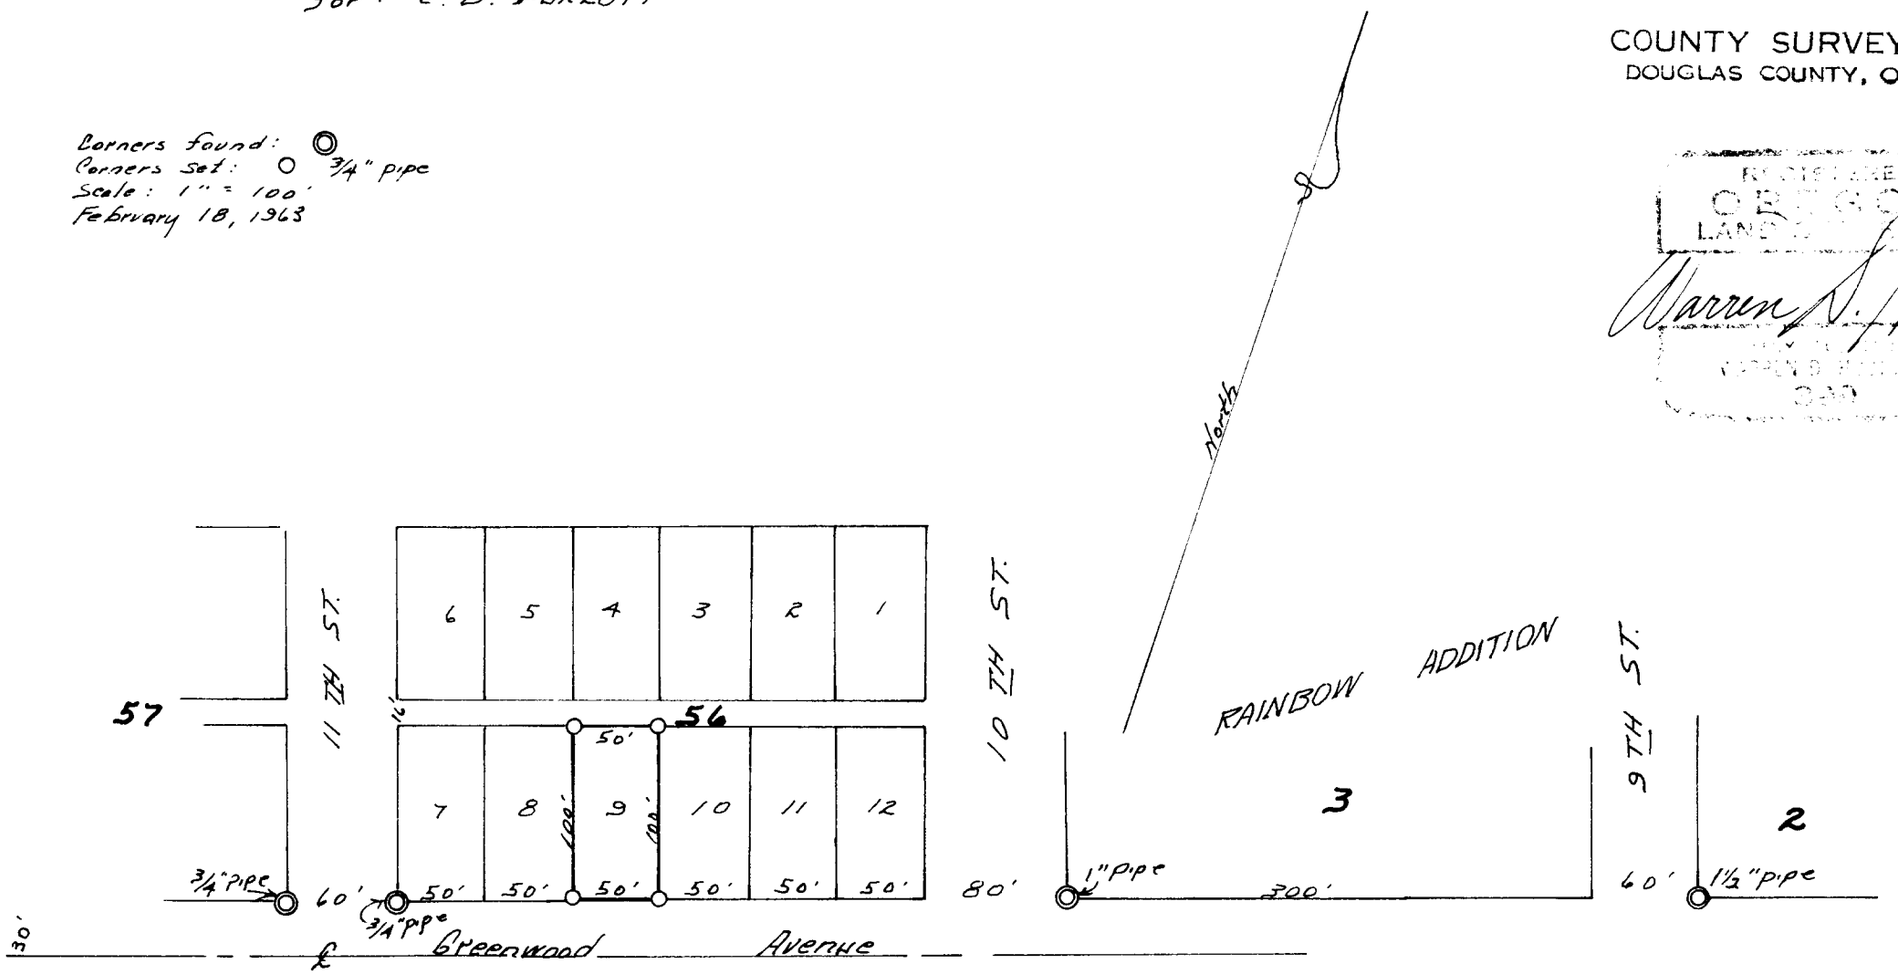


REGISTERED
OREGON
LAND SURVEYOR
Warren N. Foltman
EXPIRES DEC. 31
1963

C.S. No. 51/24377