COUNTY SURVEYOR FILE DATA
DO NOT REMOVE FROM OFFICE

FILED
RECEIVED
FEB 25 1963
COUNTY SURVEYOR
DOUGLAS COUNTY, ORE.

SURVEY TO DIVIDE THE FLOYD LENGACHER DEED DESCRIPTION

NW¼ SE¼, SECTION 4, T. 22 S., R. 12 W., W.M.,
DOUGLAS COUNTY, OREGON

Corners set: ○ ¾" pipe
Corners found: ● ¾" pipe
Scale: 1" = 100'

January 24, 1963

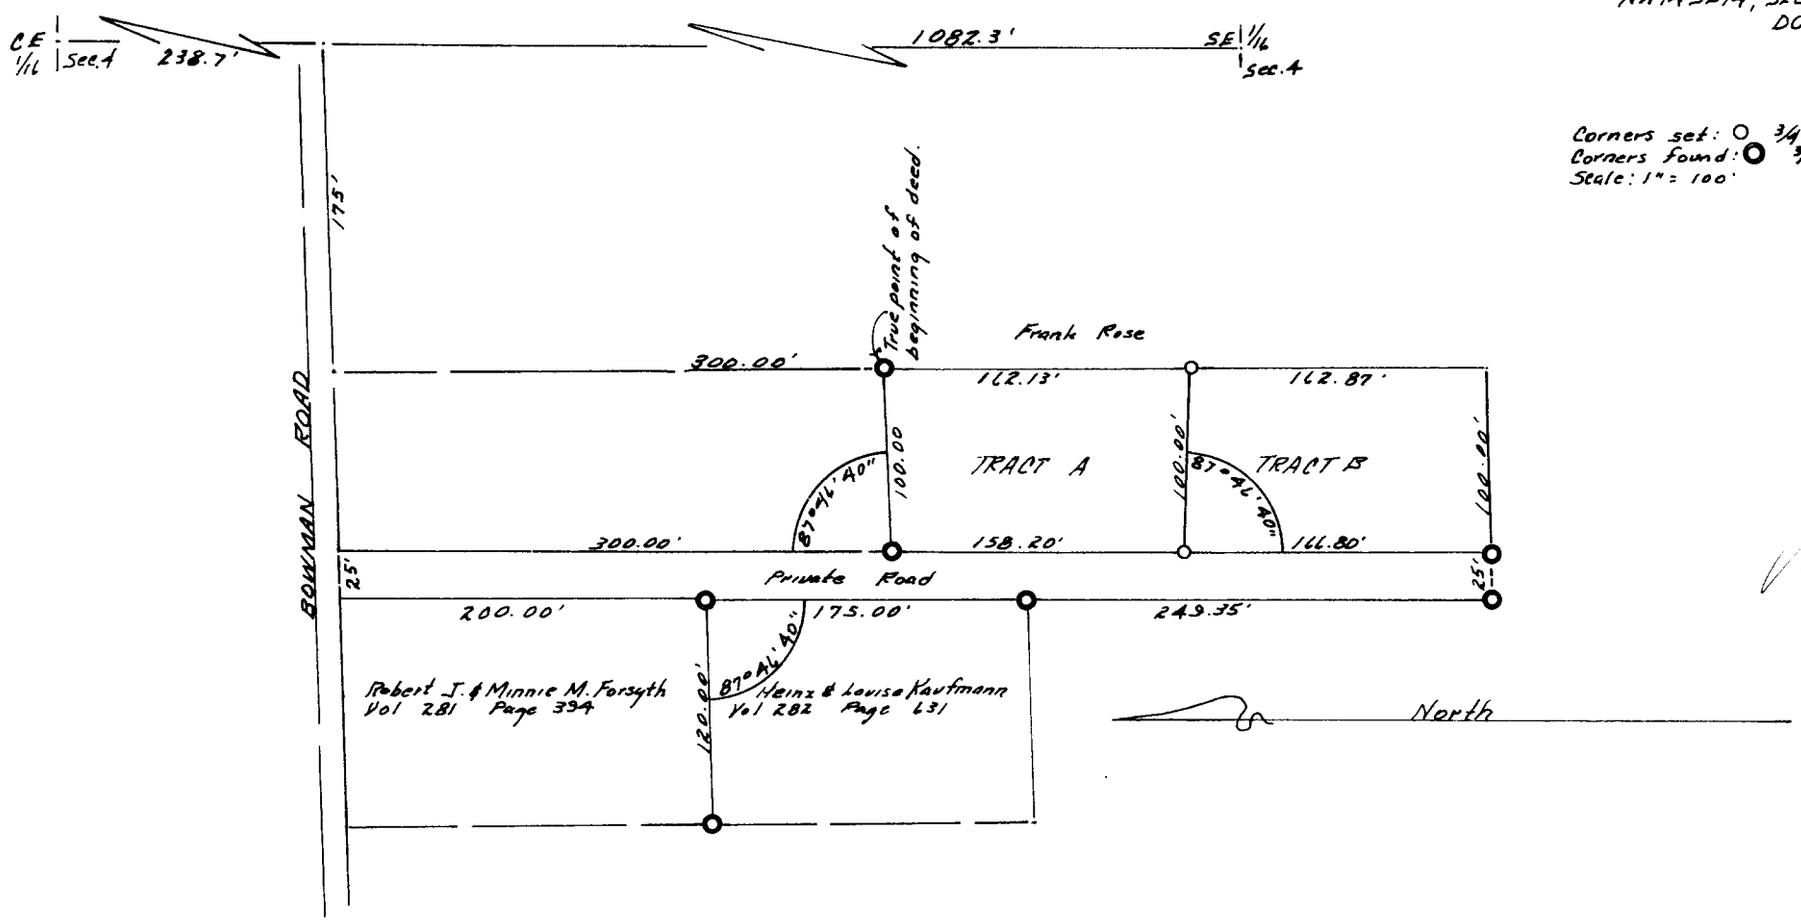

Warren A. Footman

51/243-9