COUNTY SURVEYORS FILE DATA
DO NOT REMOVE FROM OFFICE

SURVEY OF PORTION OF LOT 6, UMPQUA FRUIT RANCH SECTION 15, T. 27 S. R. 6 W. W.M. DOUGLAS COUNTY, OREGON.

SURVEYED FOR - G. C. LAURITZEN
SURVEYED BY - W. S. BARNES

SEPT. 1963
SCALE - 1" = 50'

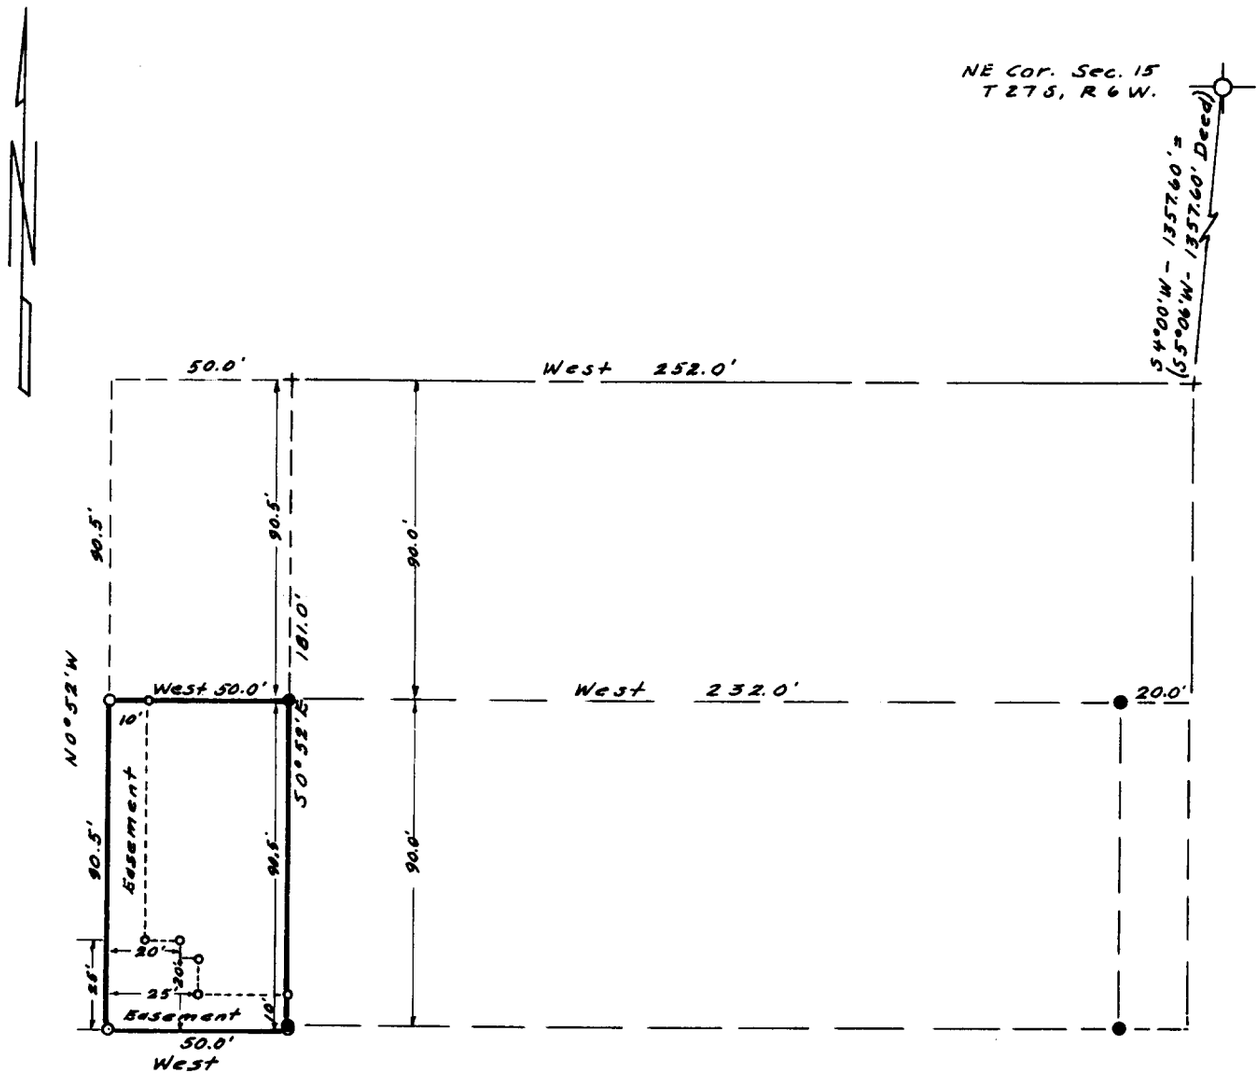

● Denotes 3/4" I. Rod Found.
○ Denotes 3/4" I. Rod Set.
Denotes 5/8" I. Rod Set.

Base of Bearings - C.S. File M 23-27.

FILED L.L.
RECEIVED
SEP 13 1963
COUNTY SURVEYOR
DOUGLAS COUNTY, ORE.

REGISTERED PROFESSIONAL ENGINEER
2128
W. S. Barnes
OREGON
SEPT. 5, 1941
William S. Barnes

C. S. File No. 51/251-3