PARCELS IN LOTS 14 & 15 · BLOCK 1
GLENGARRY FRUIT LANDS

Oren Locks

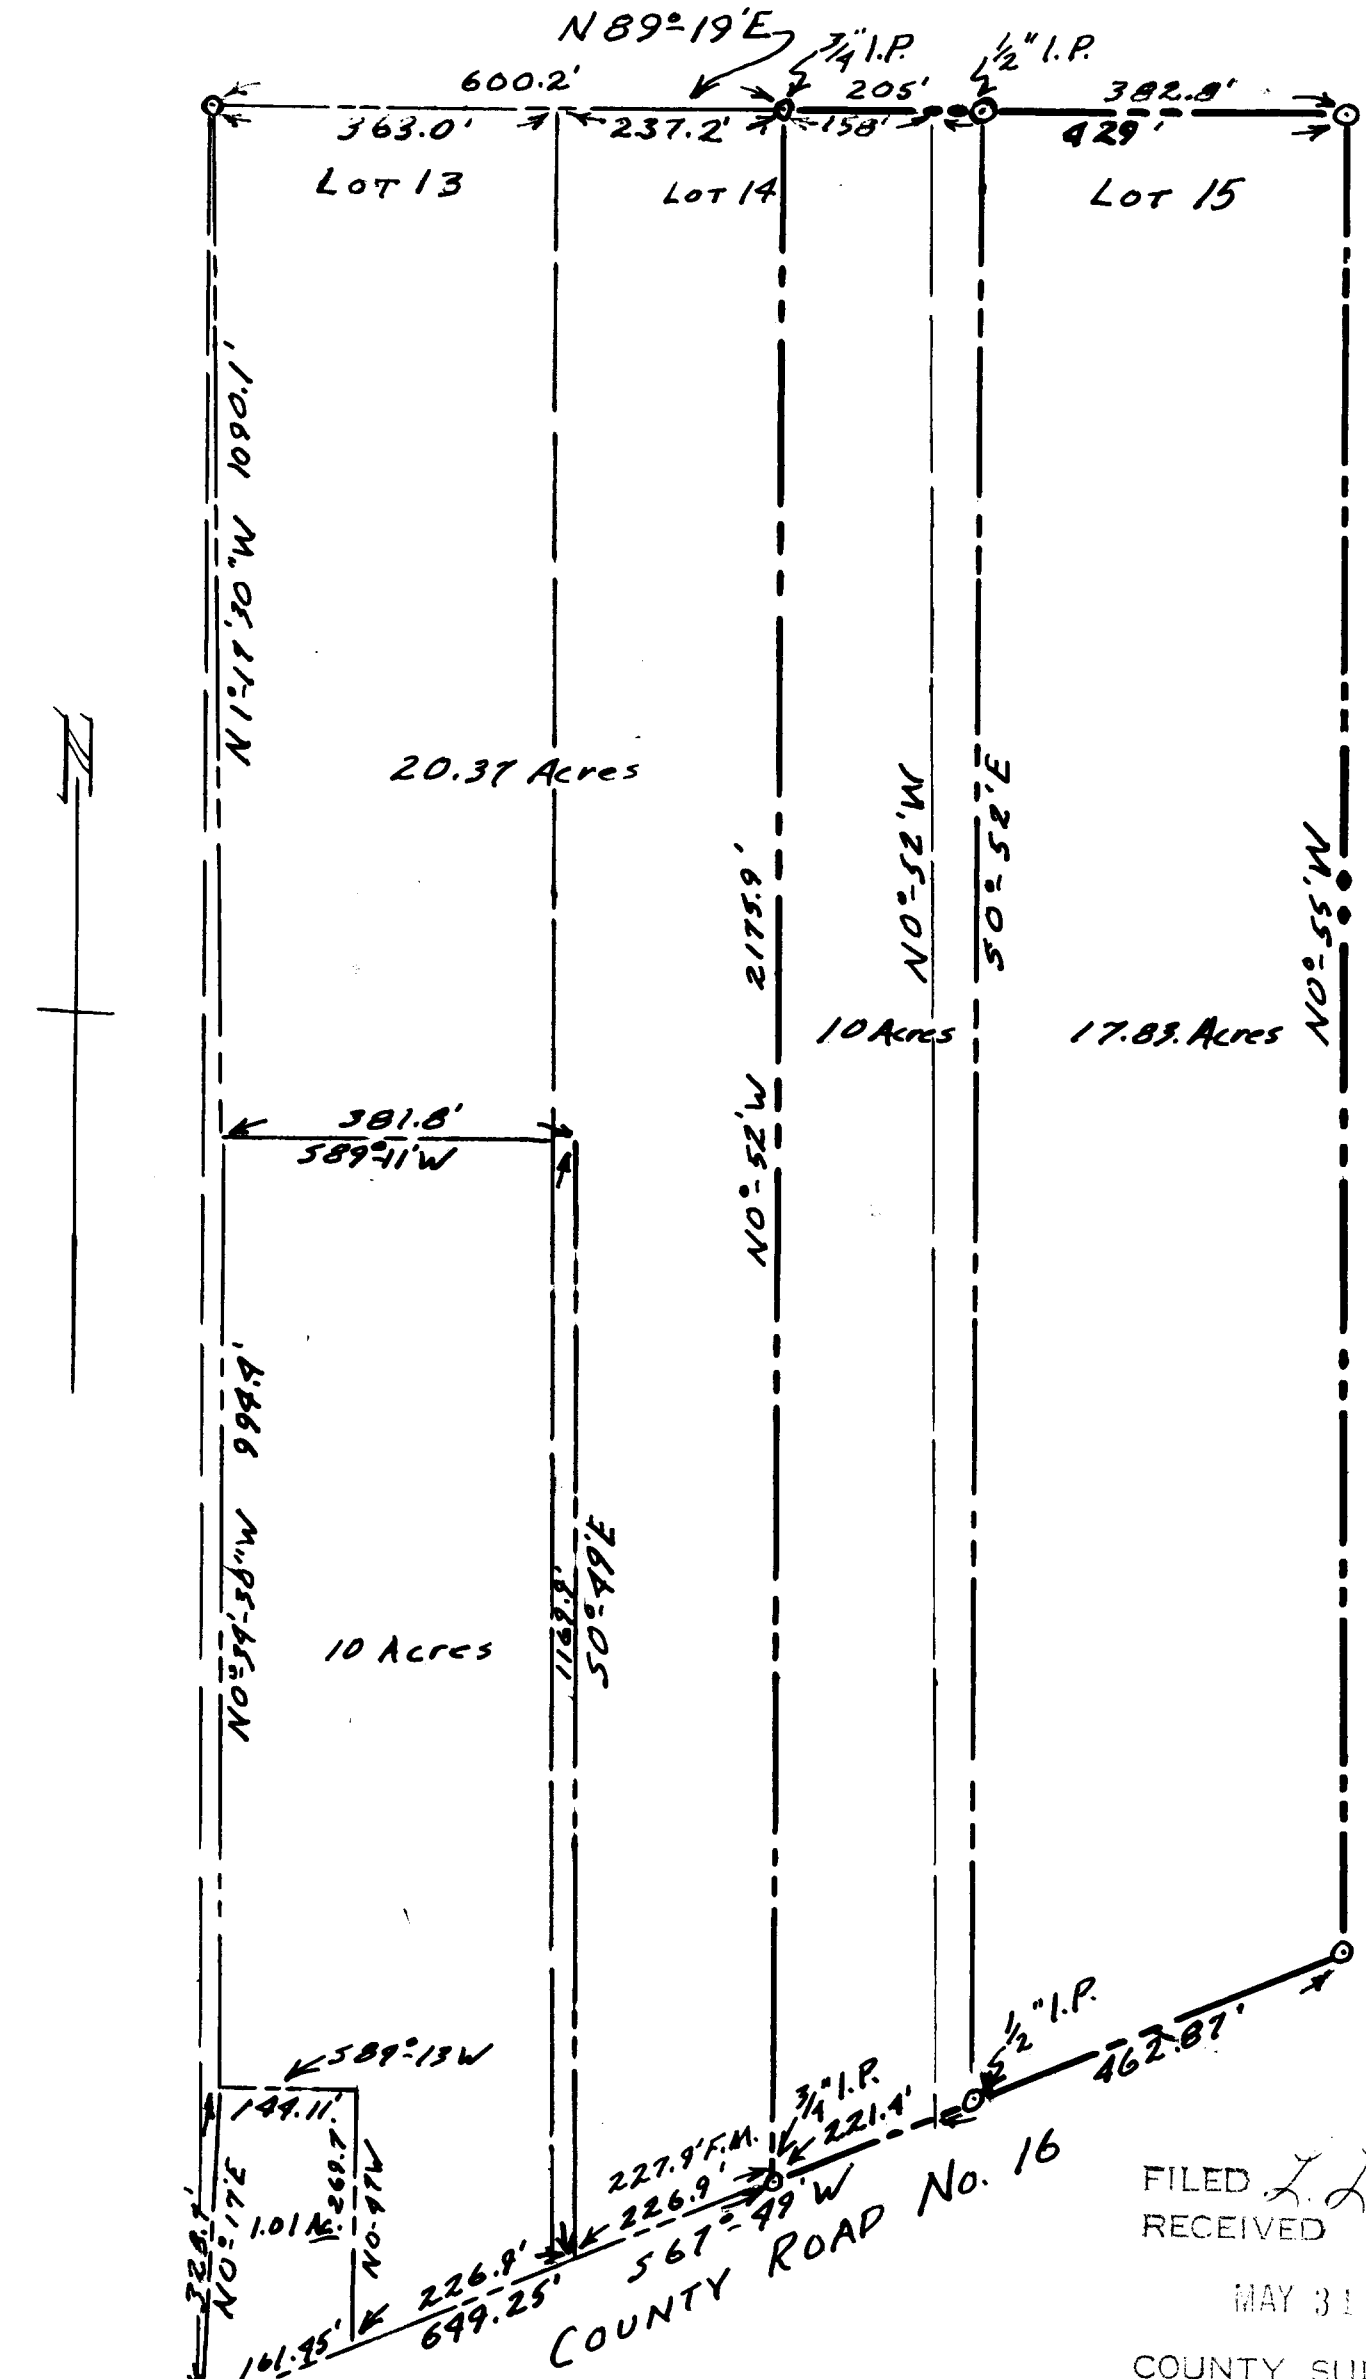

FILED
RECEIVED

MAY 31 1963

COUNTY SURVEYOR
DOUGLAS COUNTY, ORE.

James R. Daugherty

COUNTY SURVEYORS FILE DATA
DO NOT REMOVE FROM OFFICE

JAMES R. DAUGHERTY
SANITARY ENGINEER
WINSTON, OREGON

Scale 1" = 200'
April 13, 1963

C. S. File No. 51/253-