

UNITED STATES PLYWOOD CORPORATION

P. O. BOX 1328 • ROSEBURG, OREGON • PHONE OR 2-3331




MANUFACTURERS OF WELDWOOD
PLYWOOD AND ALLIED PRODUCTS

1/4 Section Corner: Sections 32 and 33, T27S, R2W
Found: 1½" Iron pipe
38" Douglas fir stump, North 53½° West, 23.8 feet
(good condition)

Set: 2½ Aluminum Cap
11" Cedar, South 48° East, 20.3 feet
Marked 1/4 S33 BT

December 1962

✓ + ○

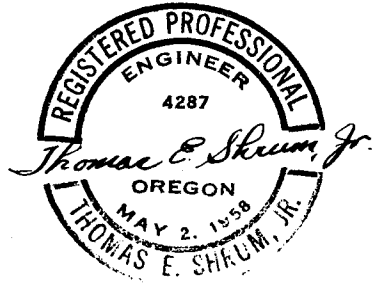

FILED
RECEIVED

APR 10 1963

COUNTY SURVEYOR
DOUGLAS COUNTY, ORE.

C. S. File No. 51/254-4